

STATE OF TEXAS  
STATE DEPARTMENT OF HIGHWAYS AND PUBLIC TRANSPORTATION

CSJ 001607105

FED. RD. DIST. NO.	STATE	FEDERAL AID PROJECT NO.	SHEET NO.
6	TEXAS	IR 35-2(199)171	1
STATE DIST. NO.	COUNTY	CONTRACT NO.	HIGHWAY NO.
15	BEXAR	16 7 105	1H 35

Coded By B. Nations 1/91  
Mapping 2/91 Posted B

LETTING DATE: FEBRUARY 7, 1990  
WORK BEGAN: APRIL 3, 1990  
DATE ACCEPTED: JUNE 20, 1990  
CONTRACTOR: SHANNON-MONK, INC.  
TOTAL COST: 92,933.27

INDEX OF SHEETS

SHEET NO.	DESCRIPTION
1	TITLE SHEET
2	BARRICADES AND CONSTRUCTION SIGNING
3-4	ESTIMATE AND QUANTITY SUMMARY
5-6	GENERAL NOTES AND SPECIFICATIONS
7-8	PLAN PROFILE SHEETS
9	CULVERT LAYOUT
10	DROP INLET DETAIL
11	PAVEMENT MARKINGS LAYOUT

STANDARD SHEETS (below)

12	IPM(1)
13	IPM(2) (MOD)
14	PM(2) (MOD) DIST 15
15	TCP(5-1)
16	TCP(5-2) MOD
17	TCP(2-5a) (2-5b)
18	PD-SPR
19	GFTD-87
20-28	SC(1-7)-89

THE STANDARD SHEETS SPECIFICALLY IDENTIFIED ABOVE HAVE BEEN ISSUED BY ME AND ARE APPLICABLE TO THIS PROJECT.



THE SEAL APPEARING ON THIS DOCUMENT WAS AUTHORIZED BY DALE R. STEIN, JR., P.E. 58109, ON OCT 29, 1988.

*Dale R. Stein, Jr.*

PROJECT LOCATION  
PROJECT NO. IR 35-2(199)171  
CONTROL 0016-07-105


SPECIFICATIONS ADOPTED BY THE STATE DEPARTMENT OF HIGHWAYS AND PUBLIC TRANSPORTATION, SEPTEMBER 1, 1982 AND SPECIFICATION ITEMS LISTED AND DATED AS FOLLOWS, SHALL GOVERN ON THIS PROJECT: REQUIRED CONTRACT PROVISIONS FOR ALL FEDERAL-AID CONSTRUCTION CONTRACTS (FORM FHWA 1273, AUGUST, 1988)

PLANS OF PROPOSED  
STATE HIGHWAY IMPROVEMENT

BEXAR COUNTY - I.H. 35  
PROJECT NO. IR 35-2(199)171

CONTROL 0016-07-105  
AT SH-218-ENTRANCE RAMP FROM FRONTAGE ROAD  
TO SH 218 CONNECTION  
FOR THE CONSTRUCTION OF MISCELLANEOUS CONSTRUCTION  
CONSISTING OF GRAD, BASE, & SURF

ROADWAY LENGTH = 1380 FT. = 0.261 MI.

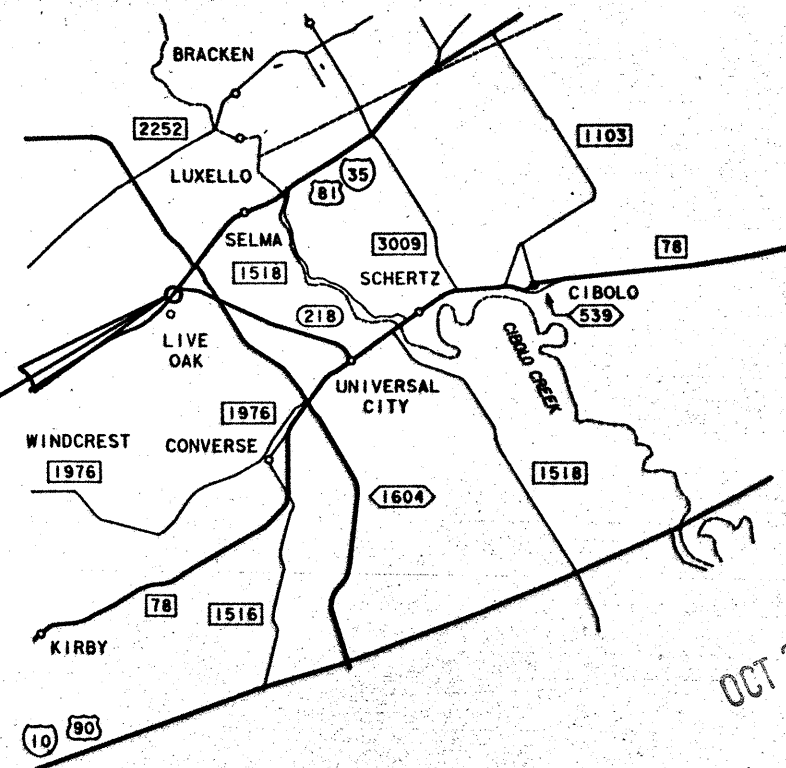

OCT 30 1990

FINAL PLANS

DESIGN SPEED = 50 MPH

LAYOUT SCALE: 1 IN. = 9250 FT.

STATE DEPARTMENT OF HIGHWAYS  
AND PUBLIC TRANSPORTATION

RECOMMENDED FOR LETTING: Nov 2, 1989

*John C. Nigh, P.E.*  
DISTRICT DESIGN ENGINEER

RECOMMENDED FOR LETTING: Nov 2, 1989

*Richard D. Doherty*  
DISTRICT ENGINEER

RECOMMENDED FOR APPROVAL:

RECOMMENDED FOR APPROVAL:

APPROVED FOR LETTING: 12-11-89

*William A. Marshall, P.E.*  
CHIEF ENGINEER OF HIGHWAY DESIGN

"I HEREBY CERTIFY THAT THESE PLANS HAVE BEEN REVISED TO SHOW THE PROJECT AS ACTUALLY CONSTRUCTED."

6-27-90 *Dale R. Stein, Jr., P.E.*  
DATE SUPV. RESIDENT ENGINEER

U. S. DEPARTMENT OF TRANSPORTATION  
FEDERAL HIGHWAY ADMINISTRATION

APPROVED:


DIVISION ADMINISTRATOR DATE

3	7913	FINAL
TOTAL SHEETS	17	AT CLOSURE
COUNTY	BEXAR	ORDERED BY
TICKET NUMBER	062330	J.C. Knight
DATE ISSUED	7-25-90	28 to 10015
PROJECT NO.	16-7-105	18 to 10015

IR 35-2(199)171

Bexar

COUNTY: BEXAR  
PROJ. NO.:  
HWY. NO.:  
DATE ACCEPTED:

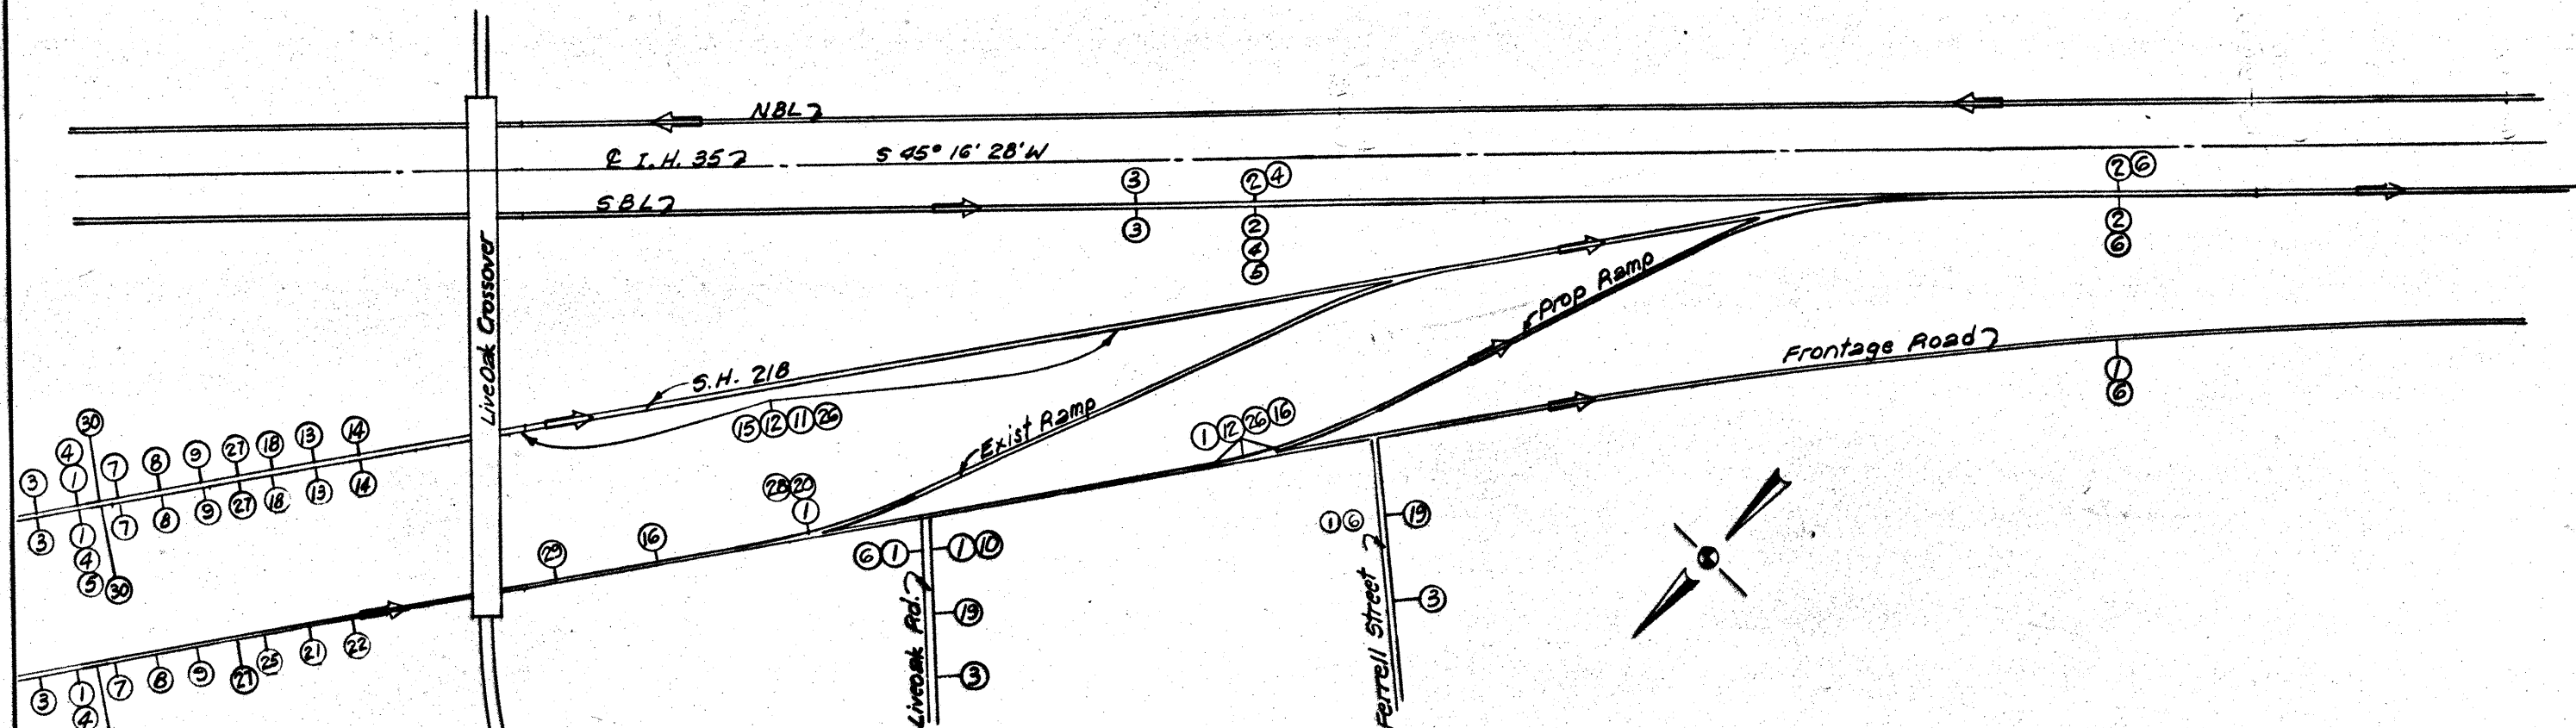

Ref No.	Barricades Signs & Type	Description	Unit	Quant
* 1	Ty III (C)	Barricade (12' Panel)	Ea	9
2	Ty III (C)	Barricade (6' Panel)	Ea	1
3	R 20-3	Observe Warning Signs	Ea	7
4	G 20-1	Road Constr Next 1 Mi	Ea	5
5	G 20-6	Contractor's Name	Ea	3
6	G 20-2	End Construction	Ea	5
7	CW 20-1A	Road Construction 1500'	Ea	3
8	CW 20-1B	Road Construction 1000'	Ea	3
9	CW 20-1C	Road Construction 500'	Ea	3
10	G 20-1b	Road Constr Next 1 Mi	Ea	1
* 11	CW 1-B	Chevrons	Ea	10
* 12		Drums	Ea	20
* 13	CW 20-5BA	Right Lane Closed 1000'	Ea	3
* 14	CW 4-2R		Ea	3
* 15	Ty I	Barricade	Ea	10
* 16	SCW 21-13R	Shoulder Drop-OFF	Ea	1
* 17	SCW 13-1	xx MPH Determined @ Site	Ea	1
* 18	CW 20-5DR	Right Lane Closed Ahead	Ea	3
19	CW 20-1D	Road Constr Ahead	Ea	2
* 20	R 11-2R	Ramp Closed	Ea	1
21	CW 20-5BL	Left Lane Closed 1000'	Ea	2
* 22	CW 4-2L		Ea	2
* 23	SCW 21-14L	Uneven Lanes	Ea	2
* 24	SCW 21-14R	Uneven Lanes	Ea	2
25	CW 20-5DL	Left Lane Closed Ahead	Ea	2
26	ECW 1-6A		Ea	10
27	SCW 13-1	45 MPH	Ea	3
* 28	M 4-10R	Detour	Ea	1
* 29	CW 20RP-3D	Ramp Closed Ahead	Ea	1
30	R 4-1	Do Not Pass	Ea	3

NOTE:  
The proposed location, type, and/or quantities of signs and barricades are for Contractor's information only.

\* These signs and barricades shall be placed as directed by the Engineer and used in conjunction with the sequence of work and traffic control plan.

Additional traffic control Details are outlined in the plans using the following standard plan sheets 20 thru 26 TCP (5-1), TCP (5-2) MOD, TCP (2-5a) and TCP (2-5b)

The taper length for lane closure on S.H. 218 ramp and north Frontage road shall be based on 12' lane width and a speed of 45 M. P. H.

Ty I Barricades shall be placed as directed by the Engineer behind the plastic drums with the CW 1-B (Chevron) or ECW 1-6A (signs mounted on them. They shall also have a warning light mounted on each sign at each setup designated for nighttime lane closures.

All permanent paint stripping will be done by state Maintenance Forces after the final ACP Mat is in place and proper notification is given.

For permanent pavement marking details, refer to plan sheets 11, 12, 13, and 14.

## BARRICADES AND CONSTRUCTION SIGNING



Dale R. Stein, Jr. Oct 24, 97  
Dale R. Stein, Jr.

FED. RD. DIV. NO.	FEDERAL AID PROJECT NO.	SHEET NO.
6	IR 35-2(199)171	2
STATE	STATE DIST. NO.	COUNTY
TEXAS	15	Brewer
CONTRACT	SECT.	JOB
16	07	105 L.H. 35

2

## GRADING SUMMARY

SHEET NO	STATION TO STATION	Remov Old Conc	Furn And Plac Tpsl	Oblit Aband Rd.	B/d d	Asph stab Bs (Gr 4)	Riprap (Conc) (Cl. B)	Term - Arch Sect (12 GA)	Metal Beam Gd Fence (12 Ga) (Tim Post)	Abbrev Pav Mark (White)	Const Pav Mark (Non Remov) (4in)(W) Solid	Const Pav Mark (Non Remov) (4in)(Y) Solid	Const Pav Mark (Non Remov) (4in)(W) Broken	Temp Flex Reflect Advy Mrk Tabs (Ty W)	Jug & C Bar Tile (Ty W)	Pav Mark (Reflect) Ty II OR	Excavation	Embank (Ord Comp) (Ty B)	Pav Mark (Reflect) (Ty IC)	Retr Prefab Pav Mark (24 in) (White) Solid
RFF		SY	STA	STA	Hr	Ton	CY	Ea	LF	LF	LF	LF	LF	Ea	Ea	Ea	CY	CY	Ea	LF
7	-4+00 to 0+00		2.80	2.80	1.0															
8	0+00 to 11+00	234	0.75	0.75	4.0	561.04	57.43	2	425								144	228		
11	Pavement Marking Detail									243	2500	2020	320	33	275	105			53	24
	Totals	234	3.55	3.55	5.0	561.04	57.43	2	425	243	2500	2020	320	33	275	105	144	228	53	24

## SMALL STRUCTURE SUMMARY

REFERENCE LISTING	SHT. NO.		DR. STR. NO.	LOCATION	DESCRIPTION	RCPipe (CI III) (30in)	Inlet Comp'l Ty 6	Safety End Treat (Ty II) (30 in)(6:1)	Trench Excav Protection																																																																																																																																																																																																																																																																																																																																																																																																																																																																																																																																																																																																																																																																																																																																																																																																																																																																																																																																																																																																																																																																																																																																																																																																																																																																																																																																																																																																	</
-------------------	----------	--	--------------	----------	-------------	------------------------	-------------------	---------------------------------------	-------------------------	--	--	----

~~LARGE STRUCTURE SUMMARY~~

[illegible]



								BEXAR COUNTY		ALT	ITEM- CODE			DESCRIPTION	UNIT	TOTAL	
								IH 35			ITEM NO	DESC CODE	SP RD				
								PROJECT IR 35-2(199)171 ROADWAY								EST.	FINAL
EST.	FINAL	EST.	FINAL	EST.	FINAL	EST.	FINAL	EST.	FINAL							EST.	FINAL
								234.000	255.000		104	006		REMOV OLD CONC (RIPRAP)	SY	234.000	255.000
								5.000	7.000		150	001		BLAD	HR	5.000	7.000
								3.550	4.000		160	001	001	FURN AND PLAC TPSL	STA	3.550	4.000
								3.550	4.000		170	001		OBLIT ABAND RD	STA	3.550	4.000
								561.040	621.250		292	010	011	ASPH STAB BS (GR 4)	TON	561.040	621.450
								90.000	96.000		320	015	004	AGGR (TY PB, GR 4)	CY	90.000	96.000
								2678.000	2760.000		320	133	004	ASPH (AC OR MC-1200) LATEX OR WFRS-2P	GAL	2678.000	2760.000
								383.000	370.520		340	023	113	ASPH CONC (TY D) (SURF)	CY	383.000	370.620
								57.430	67.920		432	008		RIPRAP (CONC) (CL B)	CY	57.430	67.920
								235.000	235.000		464	026	009	RC PIPE (CL III) (30 IN)	LF	235.000	235.000
								1.000	1.000		470	381	002	INLET (COMPL) (DROP TY 6)	EA	1.000	1.000
								1.000	1.000		477	087	002	SAFETY END TREAT (TY II) (30 IN) (6:1)	EA	1.000	1.000
								1.000	1.000		500	001	001	MOBILIZATION	LS	1.000	1.000
								2.000	2.000		502	001		BARCD, SIGN AND TRAF HANDLING	MO	2.000	2.000
								2.000	2.000		540	011		TERM-ANCH SECT (12 GA)	EA	2.000	2.000
								425.000	425.000		540	014		GAL STL BEAM GD FENCE (12 GA) (TIM POST)	LF	425.000	425.000
								2500.000	1965.000		662	014	015	CONST PAV MARK (NON-REMOV) (4IN) (W) SOLID	LF	2500.000	1965.000
								2020.000	1625.000		662	018	015	CONST PAV MARK (NON-REMOV) (4IN) (Y) SOLID	LF	2020.000	1525.000
								320.000	150.000		662	026	015	CONST PAV MARK (NON-REMOV) 4IN (W) BROKEN	LF	320.000	150.000
								243.000	152.000		664	002	013	ABBREVIATED PAV MARK (WHITE)	LF	243.000	152.000
								24.000	18.000		668	006	003	RETR PREFAB PAV MARK (24IN) (WHITE) SOLID	LF	24.000	18.000
								275.000	176.000		672	004	006	JIGGLE BAR TILE (TY W)	EA	275.000	176.000
								53.000	50.000		674	002	010	PAV MARK (REFLECT) (TY IC)	EA	53.000	50.000
								105.000	79.000		674	005	010	PAV MARK (REFLECT) (TY IICR)	EA	105.000	79.000
								144.000	144.000		1128	001		EXCAVATION	CY	144.000	144.000
								228.000	228.000		1129	005		EMBANK (ORD COMP) (TY B)	CY	228.000	228.000
								95.000	95.000		4682	001		TRENCH EXCAVATION PROTECTION	LF	95.000	95.000
								33.000	86.000		6350	002		TEMP FLEX-REFLECT RDWY MRK/TABS (TY W)			

4

STATE DIST. NO.	COUNTY	PROJECT NO.	SHEET NO.
15	BEXAR	IR 35-2(199)171	4

F.R. DIV.6	TEXAS	IR 95-2(199)171	SHEET 5
BEXAR	COUNTY	HWY IN 35	CONT 0016-7-105

GENERAL NOTES AND SPECIFICATION DATA--

GRADING REQUIREMENTS FOR ITEM 292 ASPH STAB BS (OR 4)

PERCENT RETAINED ON EACH SIEVE	LL	PI	WET BALL
1-3/4" 1-1/4" 7/8" 3/8" #4 #40 MAX MAX MIN MAX			
(292) 0 0-5 10-20 25-50 45-65 65-80 45 15 0 55			

\* THE MAXIMUM INCREASE IN MATERIAL PASSING THE NO. 40 SIEVE SHALL NOT EXCEED 20.

BASIS OF ESTIMATE

ITEM	DESCRIPTION	RATE	QUANT	UNIT
150	BLAD	0.5 HR/STA	5	HR

THE FOLLOWING FOR CONTRACTOR'S INFORMATION ONLY- NON PAY

160	SPRINK (TPSL)	500 GAL/STA		
204	SPRINK (EMB)	30 GAL/CV		
210	ROLL (FLAT WHEEL) (SURF)	1 HR/2000 SV		
211	ROLL (TAMP) (EMB)	1 HR/200 CV		
212	ROLL (MED B) (SURF)	1 HR/2000 SV		
213	ROLL (MED B) (TPSL)	0.25 HR/STA		

ASPHALTIC CONCRETE PAVEMENT

TYPE	LOCATION	DEPTH	RATE	AREA-SV	QUANT-CV
ACP-SURF	SH 210 & NFR	1-1/2"	.0417 CV/SV	7595	317
ACP-SURF	ENT RAMP	3"	.0833 CV/SV	709	66
				TOTAL	383

ONE COURSE SURFACE TREATMENT DATA

DESCRIPTION	1 ST CRSE	TOTAL
AREA	5927 SV	5927 SV
ASPH--TYPE	SEE GEN NOTES	
ASPH--RATE (GAL/SV)	0.30	2678 GAL
AGGR--TYPE/GR	PD OR 4	
AGGR--RATE (CV/SV)	1:100	90 CV

THE FOLLOWING STANDARD DETAIL SHEETS HAVE BEEN MODIFIED: IPN(2), & PN(2).

SPECIFICATION DATA

12/11 SHEET A

F.R. DIV.6	TEXAS	IR 95-2(199)171	SHEET 5
BEXAR	COUNTY	HWY IN 35	CONT 0016-7-105

GENERAL NOTES AND SPECIFICATION DATA--

ALL PAVEMENT MARKINGS SHALL BE IN ACCORDANCE WITH THE TEXAS H.U.T.C.D.

THE PERMANENT STRIPING WILL BE DONE BY STATE FORCES.

IN THOSE INSTANCES WHERE FIXED FEATURES REQUIRE, THE GOVERNING SLOPES INDICATED HEREIN MAY BE VARIED FROM BETWEEN THE LIMITS AND TO THE EXTENT DETERMINED BY THE ENGINEER.

THE LOCATION OF UTILITIES, EITHER UNDERGROUND OR OVERHEAD, SHOWN WITHIN THE RIGHT OF WAY ARE APPROXIMATE AND SHALL BE VERIFIED BY THE CONTRACTOR BEFORE BEGINNING CONSTRUCTION OPERATIONS.

THE FOLLOWING IS A LIST OF THE TELEPHONE NUMBERS OF THE UTILITY LOCATORS FOR THE VARIOUS UTILITIES THAT MAY BE ENCOUNTERED.

CITY PUBLIC SERVICE (GAS & ELECTRIC)	227-3606
S.W. BELL TELEPHONE (NORTH, WEST & DOWNTOWN)	954-4122
S.W. BELL TELEPHONE (SOUTH & EAST)	650-8220
ROGERS CABLE SYSTEM	340-8366
CITY WATER BOARD	225-7461 (EXT 800)
VALERO GAS	246-2222
AT & T	1-800-252-1139

ALL EXISTING RAISED PAVEMENT MARKINGS SHALL BE REMOVED BY THE CONTRACTOR DAILY, AS THE WORK PROGRESSES AND AS APPROVED BY THE ENGINEER. THIS WORK WILL NOT BE PAID FOR SEPARATELY BUT SHALL BE CONSIDERED SUBSIDIARY TO THE VARIOUS BID ITEMS. MATERIAL REMOVED SHALL BECOME THE PROPERTY OF THE CONTRACTOR.

IF WASTE AREAS OR MATERIAL SOURCES ARE REQUIRED FOR THE COMPLETION OF THIS PROJECT, SUCH AREAS SHALL NOT BE VISIBLE FROM ANY HIGHWAY ON THE TEXAS HIGHWAY SYSTEM UNLESS APPROVED IN WRITING BY THE ENGINEER.

MATERIALS LARGER THAN 4 INCHES IN SIZE WITHIN THE LIMITS OF THE RIGHT OF WAY AND NOT INCORPORATED IN THE FINISHED ROADWAY SECTION SHALL BE REMOVED FROM THE RIGHT OF WAY OR DISPOSED OF IN A MANNER SUITABLE TO THE ENGINEER AT THE ENTIRE EXPENSE OF THE CONTRACTOR.

---ITEM 5---  
THE CONTRACTOR SHALL ESTABLISH AND BE RESPONSIBLE FOR THE CORRECTNESS OF ALIGNMENT, ELEVATION AND POSITION OF ALL CONSTRUCTION REQUIRED BY THE CONTRACT IN ACCORDANCE WITH THE REQUIREMENTS OF SPECIAL PROVISION TO ITEM 5 (105---023).

SPECIFICATION DATA

12/11 SHEET B

F.R. DIV.6	TEXAS	IR 95-2(199)171	SHEET 5
BEXAR	COUNTY	HWY IN 35	CONT 0016-7-105

GENERAL NOTES AND SPECIFICATION DATA--

---ITEM 150---  
WORK UNDER THIS ITEM WILL CONSIST OF SHOULDERING UP PAVEMENT EDGES IN AREAS SHOWN IN THE PLANS.

---ITEM 292---  
RAW BASE MATERIAL SHALL COME FROM A SOURCE APPROVED BY THE ENGINEER. FINAL ACCEPTANCE OF BASE MATERIAL WILL BE FROM TESTS MADE FROM THE STOCKPILE OR STOCKPILES.

NO ASPHALT MIXTURE SHALL BE PLACED WHEN THE AIR TEMPERATURE IS BELOW 50 DEGREES F DURING THE PRECEDING 24 HOUR PERIOD, EXCEPT THAT A SINGLE THICK MAT (2-1/2" COMPACTED, OR GREATER) MAY BE PLACED WHEN THE AIR TEMPERATURE IS 40 DEGREES F AND RISING.

THE ASPHALT STABILIZED BASE MIXTURE SHALL BE PLACED WITH A SPREADING AND FINISHING MACHINE EQUIPPED WITH AUTOMATIC SCREED CONTROL DEVICES UNLESS OTHERWISE AUTHORIZED BY THE ENGINEER.

THE DESIGN SHALL BE IN ACCORDANCE WITH TEST METHOD TEX-126-E.

THE IN PLACE DENSITY SHALL BE MEASURED WITH THE NUCLEAR GAUGE, HOWEVER, THE CONTRACTOR WILL BE REQUIRED TO REMOVE THREE (3) EACH, 4 INCH DIAMETER UNDISTURBED CORES FOR THE FULL DEPTH OF THE PREVIOUS DAY'S PLACEMENT, AT A POINT DIRECTED BY THE ENGINEER, FOR CORRELATION. THIS REQUIREMENT FOR UNDISTURBED CORES MAY BE LATER WAIVED, IF CORRELATIONS PROVE SATISFACTORY.

IF THE MATERIALS FURNISHED ARE FOUND TO HAVE STRIPPING CHARACTERISTICS, THE ENGINEER MAY REQUIRE THE ADDITION OF AN APPROVED ANTISTRIPPING AGENT CONFORMING TO THE REQUIREMENTS OF ITEM 9373, "ASPHALT ANTISTRIPPING AGENT (LIQUEID)". THE USE OF TEST METHOD TEX-631-C SHALL NOT BE REQUIRED TO EVALUATE THE MIX. THE COST OF THE ANTISTRIPPING ADDITIVES WILL NOT BE PAID FOR SEPARATELY BUT SHALL BE CONSIDERED SUBSIDIARY TO THE VARIOUS BID ITEMS. A TEST SECTION WITHOUT THE ANTISTRIPPING AGENT WILL NOT BE REQUIRED.

THE ASPHALT PLANT SHALL BE EQUIPPED WITH TRUCK SCALES AS DEFINED IN ITEM 520.3(1) OF THE STANDARD SPECIFICATIONS. THREE WEIGHT TICKETS BEARING THE DATE, THE TRUCK NUMBER AND THE GROSS, NET AND TARE WEIGHTS SHALL BE GIVEN THE TRUCK DRIVER BY THE CONTRACTOR'S PERSONNEL, AND THEN GIVEN TO THE STATE INSPECTOR AT THE SPREADING AND FINISHING MACHINE. THE CONTRACTOR PERIODICALLY WILL BE REQUIRED TO WEIGH LOADS OF ASPHALTIC CONCRETE ON PUBLIC SCALES OR PORTABLE PLATFORM SCALES TO INSURE THE PROPER WEIGHT OF MATERIAL.

SPECIFICATION DATA

12/11 SHEET C

F.R. DIV.6	TEXAS	IR 95-2(199)171	SHEET 5
BEXAR	COUNTY	HWY IN 35	CONT 0016-7-105

GENERAL NOTES AND SPECIFICATION DATA--

---ITEM 292---, CONT'D

---ITEM 304---  
PREVIOUSLY TESTED AGGREGATES DELIVERED TO THE PROJECT, WHICH ARE FOUND TO CONTAIN EXCESSIVE QUANTITIES OF DUST (MORE THAN 0.5 PER CENT PASSING THE NO. 40 SIEVE) DUE TO DEGRADATION DURING PRECOATING, STOCKPILING OR HAULING OPERATIONS MAY BE REJECTED BY THE ENGINEER.

---ITEM 320---  
BETWEEN SEPTEMBER 1 AND MAY 1, NO ASPHALT MATERIAL SHALL BE APPLIED UNLESS, DUE TO UNUSUAL SITUATIONS, IT IS SPECIFICALLY AUTHORIZED OTHERWISE IN WRITING BY THE ENGINEER.

IT IS THE INTENT TO USE (AC-5, AC-10, AC-20) LATEX, MC 1200 (LATEX) OR HFRS-2P. MATERIAL RATES SHOWN ARE BASED ON AC AND MAY BE ADJUSTED BY THE ENGINEER DEPENDING ON THE MATERIAL USED. IN THE EVENT EMULSIONS ARE USED, A CURING PERIOD APPROVED BY THE ENGINEER SHALL ELAPSE BEFORE PLACING ANY SUBSEQUENT ASPHALT COURSES.

NO ASPHALT SHALL BE APPLIED WHEN THE AIR TEMPERATURE, AT ANY TIME, HAS BEEN BELOW 50 DEGREES F DURING THE PRECEDING 24 HOUR PERIOD UNLESS AUTHORIZED BY THE ENGINEER. THE CONTRACTOR'S ATTENTION IS CALLED TO THE STANDARD SPECIFICATION ITEM 320.1, LAST SENTENCE, "ASPHALT MATERIAL SHALL NOT BE PLACED WHEN GENERAL WEATHER CONDITIONS, IN THE OPINION OF THE ENGINEER, ARE NOT SUITABLE".

ALL PAVEMENT SHALL BE SURFACED IN LANE WIDTHS OR AS DIRECTED BY THE ENGINEER.

THE CONTRACTOR WILL BE REQUIRED TO SET A STRING LINE FOR ALL SURFACE TREATMENT OPERATIONS UNLESS OTHERWISE DIRECTED BY THE ENGINEER.

ASPHALT AND AGGREGATE RATES ARE FOR ESTIMATING PURPOSES ONLY AND MAY BE VARIED BY THE ENGINEER. AGGREGATE RATES SHALL BE KEPT TO A MINIMUM AS DIRECTED BY THE ENGINEER.

THE LOCATION OF AGGREGATE STOCKPILES SHALL BE APPROVED BY THE ENGINEER. THE AGGREGATE SHALL BE FREE OF EXCESS SURFACE MOISTURE, AS DETERMINED BY THE ENGINEER, BEFORE APPLICATION.

PRECOATED AGGREGATES, OTHER THAN LRA, MAY BE PRECOATED WITH AC-10, AC-20, MS-1, CSS-1 OR PRECOAT OIL, EXCEPT THAT WHEN EMULSIONS ARE TO BE PLACED, AC-10 OR AC-20 SHALL NOT BE USED AS THE PRECOAT MATERIAL. FLUX OIL OR EMULSIONS MAY BE USED FOR PRECOATING LRA. WHEN AC-10 OR AC-20

SPECIFICATION DATA

12/11 SHEET D

F.R. DIV.6	TEXAS	IR 95-2(199)171	SHEET 5
BEXAR	COUNTY	HWY IN 35	CONT 0016-7-105

GENERAL NOTES AND SPECIFICATION DATA--

---ITEM 320---, CONT'D  
IS USED AS THE PRECOAT MATERIAL, THE AMOUNT USED SHALL NOT EXCEED 1.0 PERCENT BY WEIGHT. THE TYPE AND AMOUNT OF PRECOAT MATERIAL WILL BE APPROVED BY THE ENGINEER PRIOR TO PRODUCTION. WHEN EMULSIONS ARE USED AS THE PRECOAT MATERIAL, THE PRECOATED AGGREGATE SHALL BE ADEQUATELY DRIED TO THE SATISFACTION OF THE ENGINEER. IT WILL BE THE RESPONSIBILITY OF THE CONTRACTOR/PRODUCER TO PROVIDE ADEQUATE DRYING AND CURING PERIODS BEFORE DELIVERY OF THE AGGREGATES. THE ENGINEER RESERVES THE RIGHT TO REJECT ANY PRECOATED AGGREGATE WHICH IS IMPROPERLY COATED OR OTHERWISE UNSATISFACTORY FOR USE.

IF THE AGGREGATES TO BE PRECOATED ARE FOUND TO HAVE STRIPPING CHARACTERISTICS, THE ENGINEER MAY REQUIRE THE ADDITION OF A LIME SLURRY. LIME MEETING THE REQUIREMENTS OF ITEM 264, "HYDRATED LIME AND LIME SLURRY", SHALL BE ADDED TO THE AGGREGATE AT THE RATE OF 1% HYDRATED LIME BY WEIGHT OF AGGREGATE. THE LIME SHALL BE ADDED TO THE AGGREGATE IN SLURRY FORM AT THE COLD FEED. THE COST OF THE LIME SHALL BE CONSIDERED SUBSIDIARY TO THIS ITEM AND WILL NOT BE PAID FOR DIRECTLY. IF APPROVED BY THE ENGINEER, THE LIME SLURRY MAY BE ADDED AT THE STOCKPILE BUT NOT MORE THAN 24 HOURS IN ADVANCE OF USE.

WARNING TO CONTRACTORS: STOCKPILES OF AGGREGATE PRECOATED WITH AC MAY GENERATE EXCESSIVE HEAT BUILD-UP RESULTING IN DAMAGE TO THE ASPHALT AND/OR AGGREGATES IF ADEQUATE COOLING HAS NOT BEEN INITIALLY PROVIDED. STOCKPILES SHOWING EVIDENCE OF EXCESSIVE HEAT BUILD-UP WILL BE REJECTED.

THE PERCENTAGE BY WEIGHT OF THE LATEX ADDITIVE (SOLID BASIS) THAT IS ADDED TO AC SHALL BE 2%. WHEN USING LATEX ASPHALT, THE CONTRACTOR SHALL USE PRECAUTIONARY MEASURES TO AVOID DRIFTING OF ASPHALT ONTO TRAFFIC AND ADJACENT PROPERTY.

---ITEM 340---  
BETWEEN NOVEMBER 1 AND MARCH 1, NO ASPHALTIC CONCRETE PAVEMENT SHALL BE PLACED UNLESS, DUE TO UNUSUAL SITUATIONS, IT IS SPECIFICALLY AUTHORIZED BY THE ENGINEER IN WRITING.

NO HOT MIX ASPHALTIC MIXTURE SHALL BE PLACED WHEN THE AIR TEMPERATURE IS BELOW 50 DEGREES F OR HAS BEEN BELOW 50 DEGREES F DURING THE PRECEDING 24 HOURS UNLESS AUTHORIZED BY THE ENGINEER. MAT THICKNESSES OF 1-1/2 INCHES AND LESS SHALL NOT BE PLACED WHEN THE TEMPERATURE OF THE SURFACE ON WHICH THE MAT IS TO BE PLACED IS BELOW 50 DEGREES F.

ASPHALT CONCRETE PAVEMENT SHALL BE PLACED WITH A SPREADING AND FINISHING MACHINE EQUIPPED WITH AUTOMATIC SCREED CONTROL DEVICES UNLESS

SPECIFICATION DATA

12/11 SHEET E

F.R. DIV.6	TEXAS	IR 95-2(199)171	SHEET 5
BEXAR	COUNTY	HWY IN 35	CONT 0016-7-105

GENERAL NOTES AND SPECIFICATION DATA--

---ITEM 340---, CONT'D  
OTHERWISE AUTHORIZED BY THE ENGINEER.

THE ASPHALT LAYING MACHINE SHALL NOT BE SERVED BY MORE THAN ONE PLANT AT A TIME.

VEHICLES OF THE HIGH DUMP SEMI-TRAILER TYPE WILL NOT BE ALLOWED TO DUMP DIRECTLY INTO THE FINISHING MACHINE UNLESS SPECIFICALLY AUTHORIZED BY THE ENGINEER.

THE USE OF A SINGLE DRUM VIBRATORY ROLLER FOR BREAKDOWN ROLLING WILL NOT BE ALLOWED.

AUTOMATIC PROPORTIONING DEVICES WILL BE REQUIRED ON ALL PLANTS UNLESS OTHERWISE DIRECTED BY THE ENGINEER.

THE CONTRACTOR MAY ELECT TO USE STONE SCREENINGS FOR FINE AGGREGATE AS OUTLINED IN ITEM 340.2 (1)(C). IF STONE SCREENINGS ARE USED, THE MAXIMUM AMOUNT OF COARSE AGGREGATE CONTAINED IN THE FINE AGGREGATE STOCKPILES IS INCREASED FROM 20% TO 30%.

FOR COARSE AGGREGATES, IF THE AMOUNT OF MATERIAL PASSING THE NO. 10 SCREEN IS 6% OR LESS, THE P1 TEST REQUIREMENT IS WAIVED.

THE TOTAL AMOUNT OF MATERIALS RETAINED BETWEEN THE 40-80 AND 80-200 SIEVES SHALL NOT BE LESS THAN 20% OF THE PAVING MIXTURE.

THE COARSE AGGREGATE USED IN THE SURFACE COURSE OF THE TRAVEL LANES SHALL HAVE AN ABRASION LOSS OF NOT MORE THAN 37% BY WEIGHT WHEN SUBJECTED TO THE LOS ANGELES ABRASION TEST.

THE COARSE AGGREGATE USED IN THE SURFACE COURSE OF THE TRAVEL LANES WILL BE SUBJECTED TO 4 CYCLES OF THE SOUNDNESS TEST IN ACCORDANCE WITH TEST METHOD TEX-411-A. THE LOSS SHALL NOT BE GREATER THAN 30 WHEN MAGNESIUM SULPHATE IS USED. THIS TEST WILL NOT APPLY TO BLENDS WITH CRUSHED TRAPROCK OR CRUSHED FLINTROCK.

ONLY AC-20 SHALL BE USED.

THE COARSE AGGREGATE MAY BE SAMPLED DURING DELIVERY TO THE PLANT, FROM THE STOCKPILE, FROM THE COLD BINS, OR FROM THE HOT BINS AS DIRECTED BY THE ENGINEER.

IF THE MATERIALS FURNISHED ARE FOUND TO HAVE STRIPPING CHARACTERISTICS, THE ENGINEER MAY REQUIRE THE ADDITION OF AN APPROVED ANTISTRIPPING AGENT CONFORMING TO THE REQUIREMENTS OF ITEM 9373, "ASPHALT

SPECIFICATION DATA

12/11 SHEET F

F.R. DIV. 6	TEXAS	IR 95-2(199)171	SHEET 6
BEAR	COUNTY	HWY IN 35	CONT 0016-7-105

GENERAL NOTES AND SPECIFICATION DATA--

---ITEM 340---, CONT'D  
ANTISTRIPPING AGENT (LIME), OR ITEM 9374, "ASPHALT ANTISTRIPPING AGENT (LIQUID)". THE USE OF TEST METHOD TEX-531-C SHALL NOT BE REQUIRED TO EVALUATE THE MIX. THE COST OF THE ANTISTRIPPING ADDITIVES WILL NOT BE PAID FOR SEPARATELY BUT SHALL BE CONSIDERED SUBSIDIARY TO THE VARIOUS BID ITEMS. A TEST SECTION WITHOUT THE ANTISTRIPPING AGENT WILL NOT BE REQUIRED.

THE COARSE AGGREGATE USED IN THE MAT DESIGNATED ACP (SURF) SHALL HAVE A MINIMUM POLISH VALUE OF 32. IF FLINTROCK OR TRAPROCK IS USED, THE POLISH VALUE WILL BE WAIVED, PROVIDING THE FOLLOWING CRITERIA IS MET: THAT PORTION OF THE FLINTROCK OR TRAPROCK RETAINED ON THE NO. 10 SIEVE SHALL COMPOSE OF AT LEAST 30% BY VOLUME OF THE TOTAL AGGREGATE. IN ADDITION, IF NATURALLY BLENDED OR MECHANICALLY BLENDED AGGREGATES ARE USED, THE BLENDED AGGREGATES SHALL CONTAIN AT LEAST 50% FLINTROCK OR TRAPROCK RETAINED ON THE NO. 4 SIEVE.

CRUSHED LIMESTONE OR CRUSHED DOLOMITE MAY NOT BE USED AS THE POLISH VALUE AGGREGATE.

THE LONGITUDINAL JOINTS SHALL BE AT THE LANE LINES OR AS DIRECTED BY THE ENGINEER.

THE ASPHALT PLANT SHALL BE EQUIPPED WITH TRUCK SCALES AS DEFINED IN ITEM 620.3(1) OF THE STANDARD SPECIFICATIONS. THREE WEIGHT TICKETS BEARING THE DATE, THE TRUCK NUMBER, AND THE GROSS, NET AND TARE WEIGHTS SHALL BE GIVEN TO THE TRUCK DRIVER BY THE CONTRACTOR'S PERSONNEL, AND THEN GIVEN TO THE STATE INSPECTOR AT THE SPREADING AND FINISHING MACHINE. THE CONTRACTOR PERIODICALLY WILL BE REQUIRED TO WEIGH LOADS OF ASPHALTIC CONCRETE ON PUBLIC SCALES OR PORTABLE PLATFORM SCALES TO INSURE THE PROPER WEIGHT OF MATERIAL.

---ITEM 420---  
ALL CONCRETE STRUCTURES SHALL RECEIVE A GRADE III FINISH.

---ITEM 421---  
THE ENGINEER WILL SAMPLE ALL CONCRETE AND MAKE AND TEST ALL TEST BEAMS AND CYLINDERS IN ACCORDANCE WITH TEST METHODS TEX-418-A AND TEX-420-A.

THE CONTRACTOR SHALL FURNISH AND PROPERLY MAINTAIN ALL TEST MOLDS. THE TEST MOLDS SHALL MEET THE REQUIREMENTS OF TEST METHODS TEX-418-A AND TEX-420-A AND, IN THE OPINION OF THE ENGINEER, MUST BE SATISFACTORY FOR USE AT THE TIME OF USE. IN ADDITION, THE CONTRACTOR SHALL BE

SPECIFICATION DATA

12/11 SHEET 0

F.R. DIV. 6	TEXAS	IR 95-2(199)171	SHEET 6
BEAR	COUNTY	HWY IN 35	CONT 0016-7-105

GENERAL NOTES AND SPECIFICATION DATA--

---ITEM 421---, CONT'D  
RESPONSIBLE FOR FURNISHING PERSONNEL TO REMOVE THE TEST SPECIMENS FROM THE MOLDS AND TRANSPORTING THEM TO THE PROPER CURING LOCATION AT THE SCHEDULE DESIGNATED BY THE ENGINEER AND IN ACCORDANCE WITH THE GOVERNING SPECIFICATION. FOR ALL CONCRETE ITEMS, THE CONTRACTOR SHALL HAVE A WHEELBARROW, OR OTHER CONTAINER ACCEPTABLE TO THE ENGINEER, AVAILABLE TO USE IN THE SAMPLING OF THE CONCRETE.

ALL LABOR AND EQUIPMENT FURNISHED BY THE CONTRACTOR WILL BE CONSIDERED SUBSIDIARY TO THE VARIOUS BID ITEMS AND WILL NOT BE PAID FOR DIRECTLY.

---ITEM 432---  
IN ALL RIPRAP SLOPES, 3 INCH DIAMETER WEEP HOLES AT 10 FOOT MAXIMUM SPACING BACKED WITH LOOSE GRADED GRAVEL OR CRUSHED STONE AND GALVANIZED HARDWARE CLOTH SHALL BE PROVIDED AS DIRECTED BY THE ENGINEER.

IN AREAS WHERE GUARD FENCE POSTS ARE TO BE PLACED IN RIPRAP, THE RIPRAP SHALL HAVE A BLOCKED OUT AREA AT LEAST 12 INCHES LARGER THAN THE POST.

---ITEM 437---  
HIGH RANGE WATER REDUCERS WILL BE USED ONLY TO MEET SPECIAL REQUIREMENTS AND WILL REQUIRE THE WRITTEN APPROVAL OF THE ENGINEER ON EACH SPECIFIC PROJECT. A SATISFACTORY WORK PLAN FOR CONTROL SHALL BE SUBMITTED BY THE CONTRACTOR FOR APPROVAL AND AN EVALUATION OF THE CONCRETE CONTAINING THE ADMIXTURE WILL BE PERFORMED BY THE ENGINEER.

---ITEM 464---  
THE USE OF THE COLD APPLIED, PLASTIC ASPHALT SEWER JOINT COMPOUND WILL BE PERMITTED.

---ITEM 470---  
ALTERNATE DESIGN DRAWINGS BEARING THE SEAL OF A REGISTERED PROFESSIONAL ENGINEER WILL BE ACCEPTABLE FOR PRECAST CONSTRUCTION OF INLETS, MANHOLES AND JUNCTION BOXES. SHOP DRAWINGS WILL NOT BE REQUIRED.

---ITEM 500---  
"MATERIALS ON HAND" PAYMENTS WILL NOT BE CONSIDERED IN FIGURING PERCENTAGES USED TO COMPUTE PAYMENT FOR ITEM 500, "MOBILIZATION".

SPECIFICATION DATA

12/11 SHEET 6

F.R. DIV. 6	TEXAS	IR 95-2(199)171	SHEET 6
BEAR	COUNTY	HWY IN 35	CONT 0016-7-105

GENERAL NOTES AND SPECIFICATION DATA--

---ITEM 506---  
ANY REQUIRED TEMPORARY EROSION CONTROL WORK WILL BE HANDLED AS CONTRACTOR FORCE ACCOUNT OR AGREED UNIT PRICE WORK UNDER THIS ITEM.

---ITEM 540---  
TIMBER POSTS SHALL HAVE BEVELED TOPS AND SHALL NOT BE PAINTED.

AFTER THE GUARD FENCE IS INSTALLED, THE BLOCKED OUT RIPRAP AREA AROUND THE POST SHALL BE BACKFILLED FOR A DEPTH OF 4 INCHES WITH AN ASPHALTIC MIXTURE OR CONCRETE RIPRAP APPROVED BY THE ENGINEER.

---ITEM 662---  
PAINT AND BEADS MAY BE PURCHASED FROM THE DEPARTMENT AND WILL BE CHARGED AS FOLLOWS:  
PAINT (TRAFFIC, WHITE) \$50.60 PER 5 GAL BKT OR \$549.60 PER 55 GAL DRUM  
PAINT (TRAFFIC, YELLOW) \$41.40 PER 5 GAL BKT OR \$465.00 PER 55 GAL DRUM  
CENTER STRIPE GLASS BEADS \$9.60 PER 50 LB BAG

---ITEM 664---  
AFTER STANDARD PAVEMENT MARKINGS HAVE BEEN PLACED, THE CONTRACTOR SHALL REMOVE ALL ABBREVIATED PAVEMENT MARKINGS WHOSE LOCATION DOES NOT COINCIDE WITH THAT OF THE STANDARD MARKINGS.

---ITEM 668---  
WHERE DIMENSIONAL LAYOUTS ARE NOT SHOWN ON THE PLANS, THE PLACEMENT OF 24" STOP LINES SHALL BE AS DIRECTED BY THE ENGINEER.

---ITEMS 672 & 674---  
ONLY "BITUMINOUS" ADHESIVE WILL BE PERMITTED WHEN PLACING THE RAISED PAVEMENT MARKERS.

RAISED PAVEMENT MARKERS SHALL NOT BE PLACED UNTIL THE ASPHALT CONCRETE PAVEMENT SURFACE HAS CURED A MINIMUM OF 48 HOURS.

---ITEMS 1128 & 1129---  
PRIOR TO CONTRACT LETTING, PRINTS OF EARTHWORK CROSS SECTIONS WILL BE AVAILABLE AT THE RESIDENT ENGINEER'S OFFICE FOR PURCHASE FROM THE DEPARTMENT BY THE PROSPECTIVE BIDDERS.

SPECIFICATION DATA

12/11 SHEET 1

F.R. DIV. 6	TEXAS	IR 95-2(199)171	SHEET 6
BEAR	COUNTY	HWY IN 35	CONT 0016-7-105

GENERAL NOTES AND SPECIFICATION DATA--

---ITEM 1129---  
SPRINKLING AND ROLLING WILL NOT BE PAID FOR DIRECTLY BUT SHALL BE CONSIDERED SUBSIDIARY. WATER USED FOR SPRINKLING SHALL CONFORM TO ITEM 204, "SPRINKLING", EXCEPT FOR MEASUREMENT AND PAYMENT.


---ITEM 6350---  
TEMPORARY FLEXIBLE-REFLECTIVE ROADWAY MARKER TABS SHALL BE REMOVED BY THE CONTRACTOR DAILY AS THE ACP OPERATIONS PROGRESS.

SPECIFICATION DATA

12/11 SHEET J


6



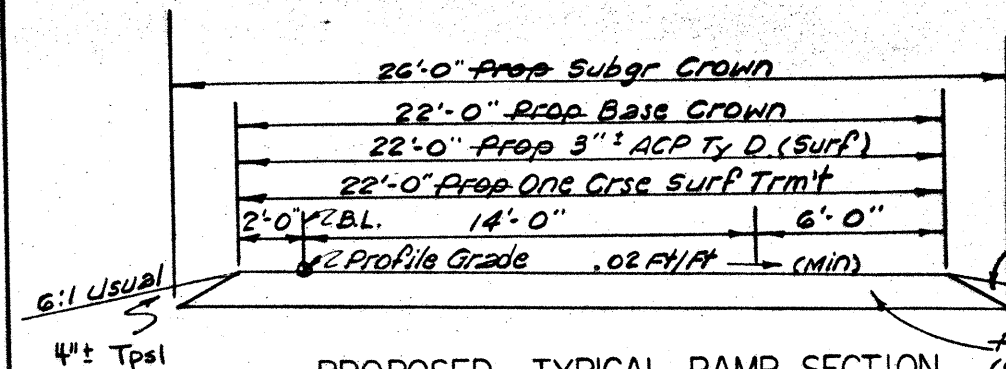

PROPOSED TYPICAL RAMP SECTION

Prop 12" Asph Stab. Base  
 (Gr. 4) Est @ 177.78 Tons/ Sta.  
 To be placed in 4 Approx.  
 equal mats.

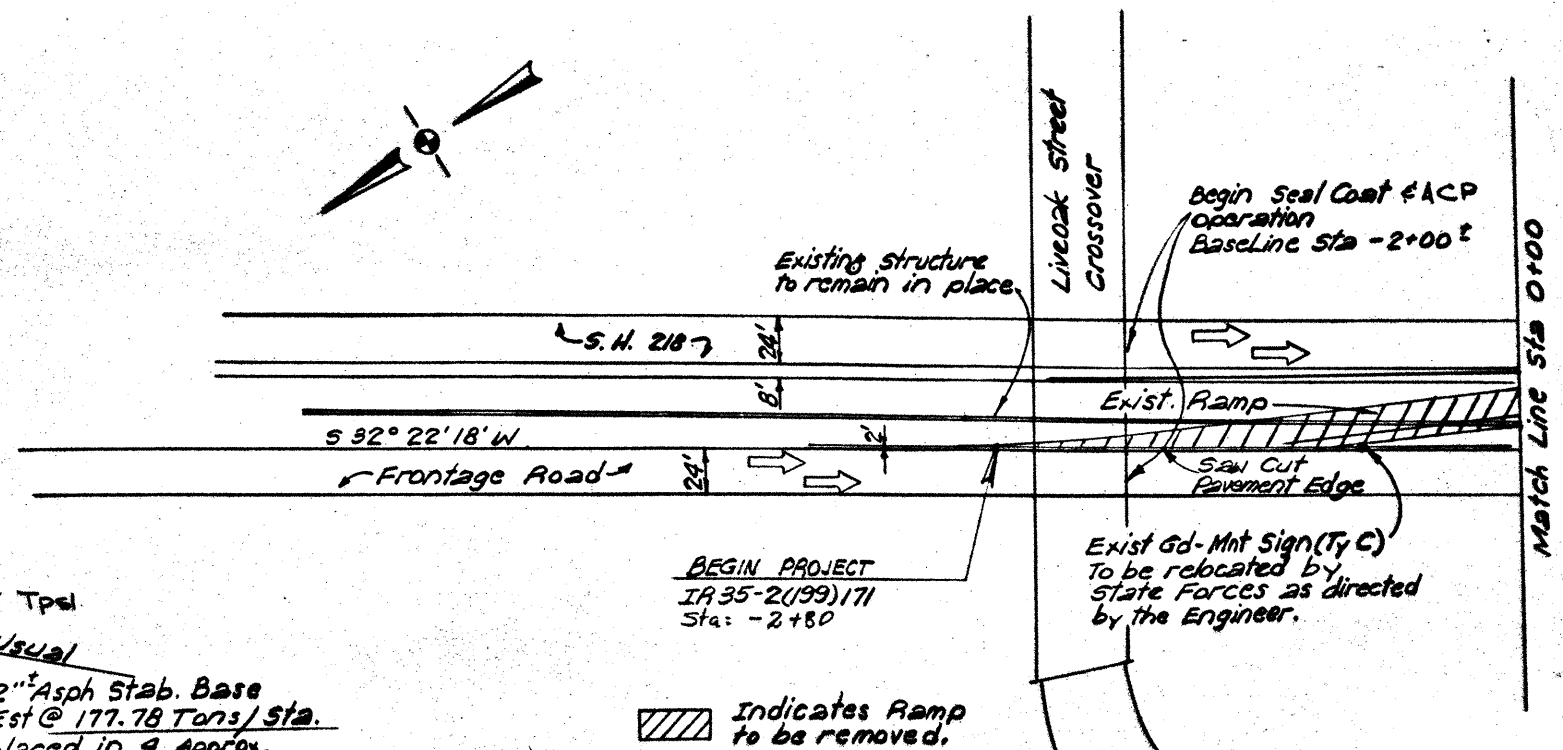

SHEET TOTALS			
EST.	FINAL	UNIT	DESCRIPTION
2.80	3.25	STA	Obilit Aband Rd
1.0	2.0	Hr	Blading
2.80	3.25	Sta	Furn and Plac Tpsl



Dale R. Stein, Jr. P.E. Oct 24, 97  
 Dale R. Stein, Jr.

PLAN PROFILE

7



FED. RD. DIV. NO.	6	FEDERAL AID PROJECT NO.	IA 35-2(99)171	SHEET NO.	7
STATE	TEXAS	STATE DIST. NO.	15	COUNTY	Brewer
CONF.	16	SECT.	07	JOB	105
				HIGHWAY NO.	I.H. 35

-4+00 -3+00 -2+00 -1+00

NOTE:  
At Sta 1+60 extend pavement edge  
line at 50:1 taper back across  
8' shoulder 400 ft.  
Sta 1+60 to 3+00 install Gore  
treatment with jable bars.  
For details See sheet No. 11

NOTE:  
In those areas where the front slopes  
are paved the Contractor will be required  
to repair any damage done due to  
construction. This work will be paid  
for under varies bid items For Items 320

Superelevation Data Note  
The ramp cross slope is graded to match  
the existing superelevation.

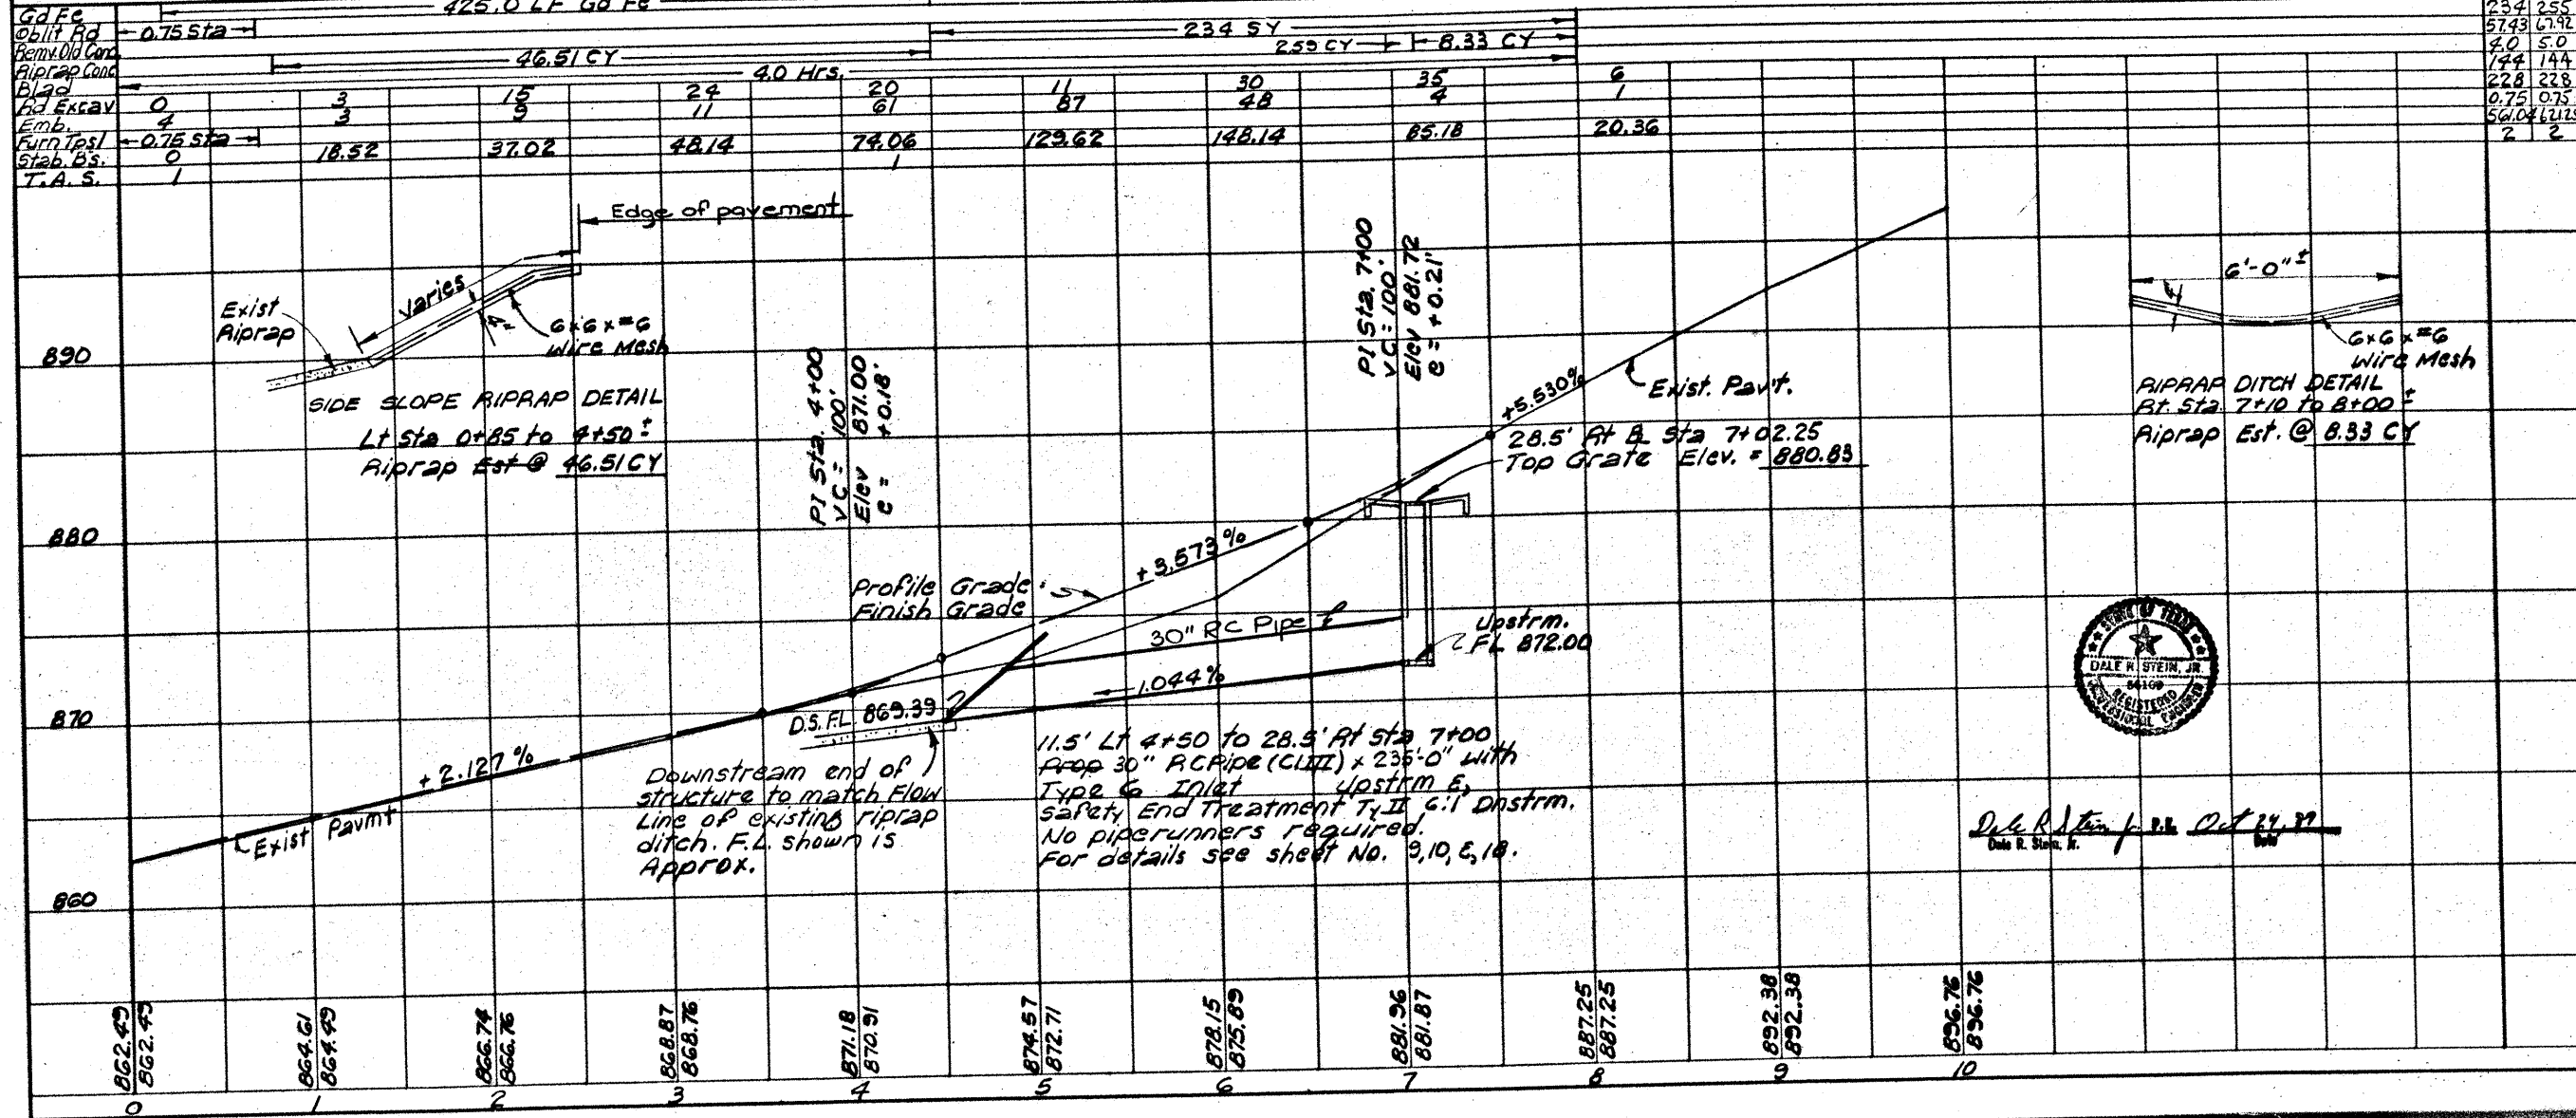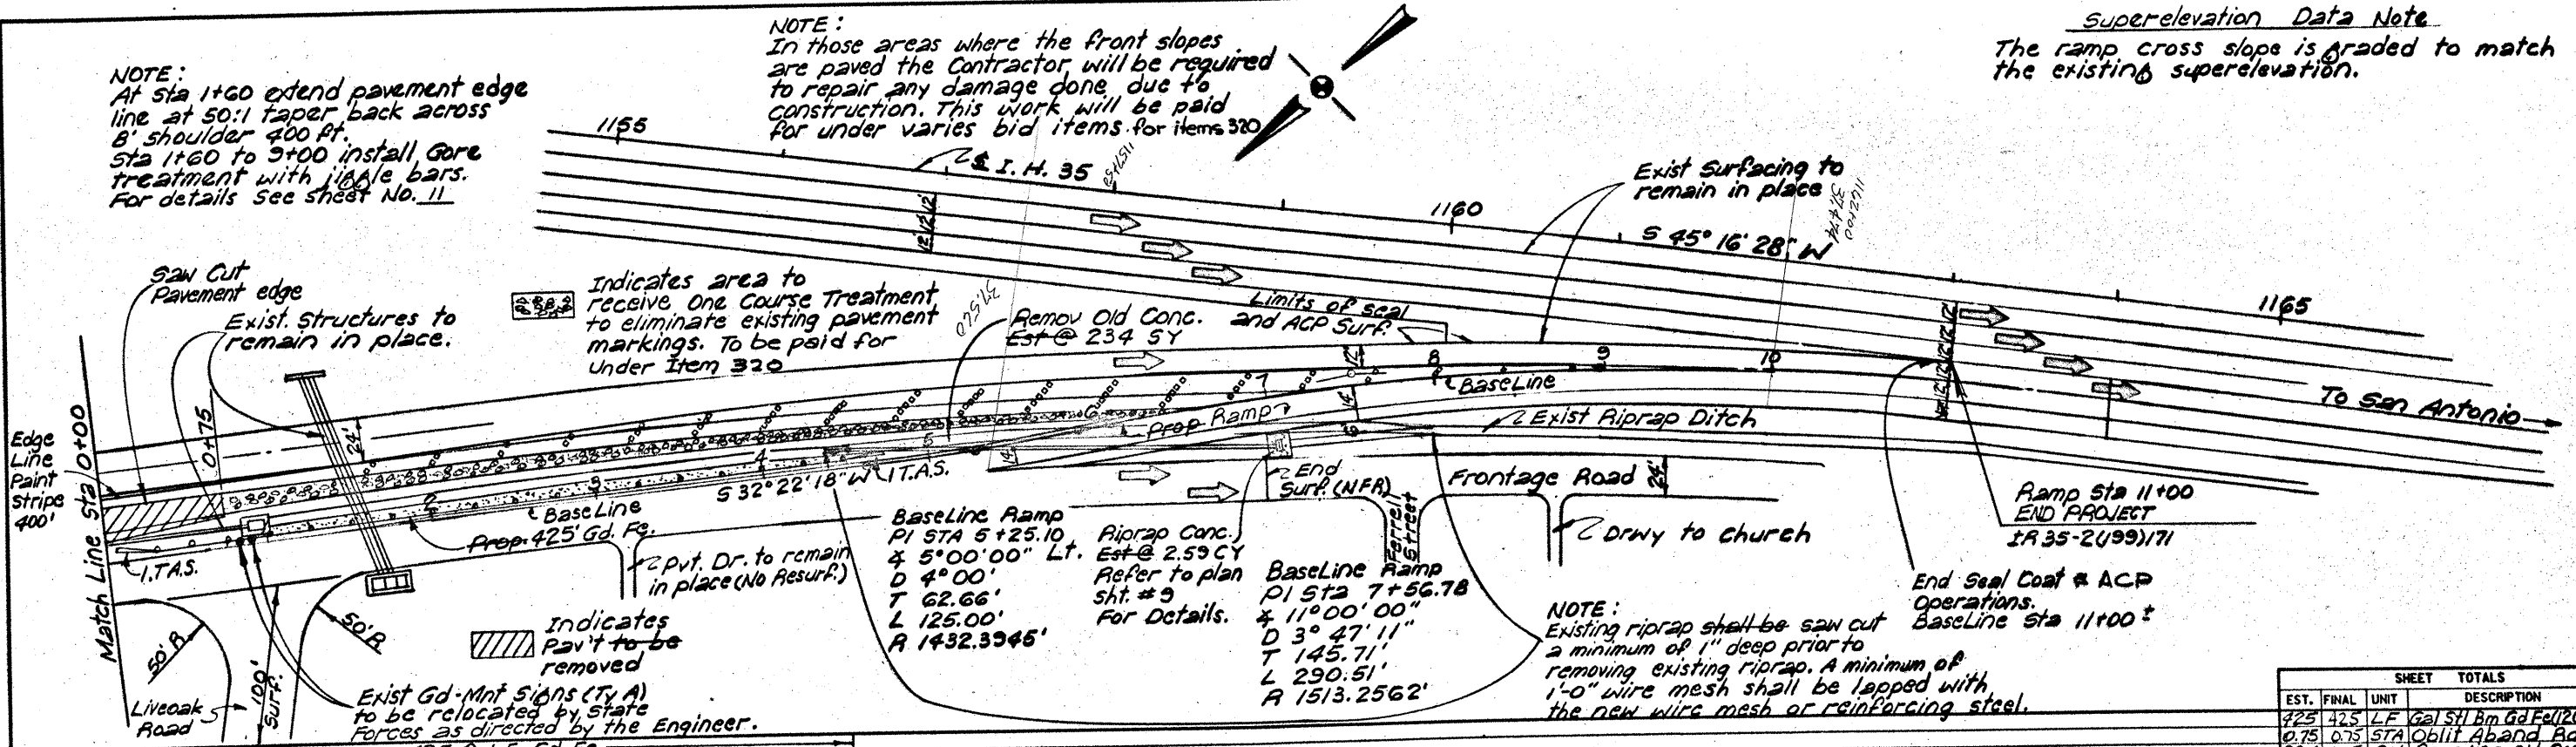

SHEET TOTALS		EST.	FINAL	UNIT	DESCRIPTION
225	425	LF	Gal	5th Bm Gd Fell (2Ga)	
0.75	0.75	STA	Oblit	Aband. Rd.	
234	255	SY	Removing	old Concrete	
5143	6792	CY	Riprap	Conc (Cl. B)	
4.0	5.0	HC	Blading		
144	144	CY	Road	Excav (Ord Comp)	
228	228	CY	Embankment	(Ord Comp)	
0.75	0.75	STA	Furn	And Plac Tps	
561.04	671.15	ton	Asph	Stab B. (Gr 4)	
2	2	Ea	Term	Anch Sect (2 Ga)	



BM # 35-IN  
Brass Disc in Concrete  
150.5' At I.H. 35 Sta.  
1132+86 Elev 893.76

TBM:  
1'0" on N.W. corner of  
Riprap Inlet 30' E  
At Baseline  
Sta 1+60 Elev 863.91

PLAN PROFILE

FED. NO.	STATE	FED. AID PROJECT NO.	SHEET NO.
6	TX	1A 35-2(199)171	2
STATE	STATE	STATE	STATE
TEXAS	15	884.87	
CONT.	SECT.	JOB	PROPERTY NO.
16	07	105 F.H. 85	





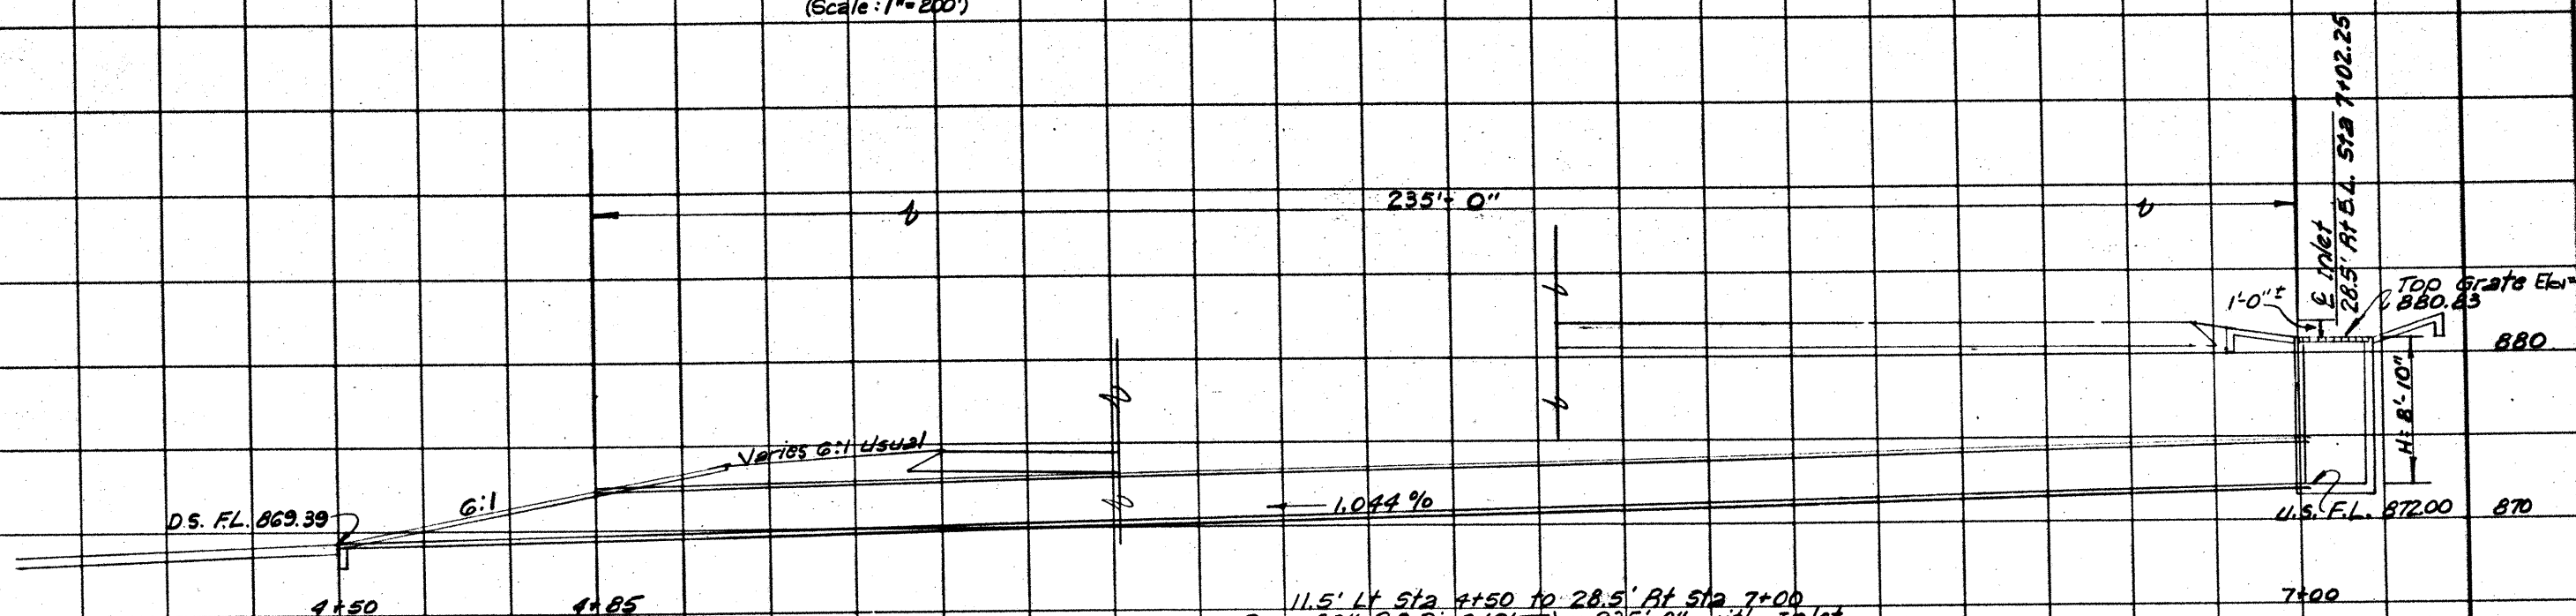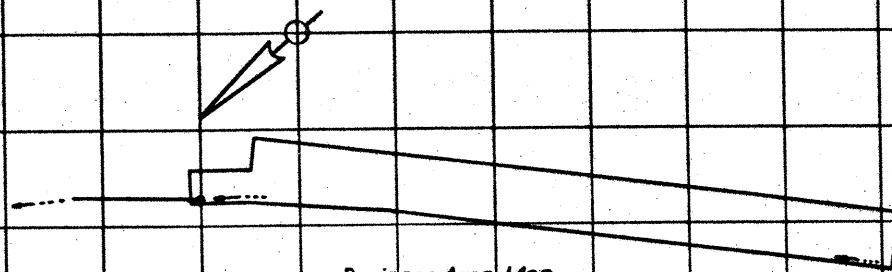

Runoff Computations (Tc = 10 Minutes)

Acres	Freq Yrs	C x A	'S' in/Hr	'Q' CFS	'H' Gate Feet
3.9	10	3.32	8.07	27	1'


Note: proposed 30" RCP @ 1.044% slope,  $V_u = 9.6$  ft/s, capacity = 45 cfs.

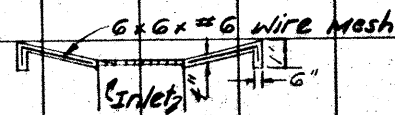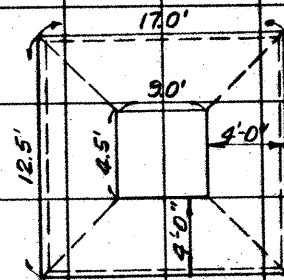

Riprap Detail  
Riprap Est @ 2.53 CY

#### ESTIMATED QUANTITIES

ITEM	QUANT	UNIT
Inlet Compl Ty 6	1	Ea.
RC Pipe (C.I.III) 30"	235	LF
Safety End Treat (Ty II) (30 in) (6:1)	1	Ea.
Trench Excavation Protection	95	LF

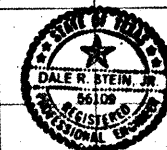


CULVERT LAYOUT


Dale R. Stein, Jr. P.E. Oct 24, 2012

9


FED. RD. DIST. NO.	FEDERAL AID PROJECT NO.	SHEET NO.
6	TR 35-2(199)171	9
STATE	DIST. NO.	COUNTY
TEXAS	15	Bexar
CONT.	SECT.	JOB
16	07	105 IH 35

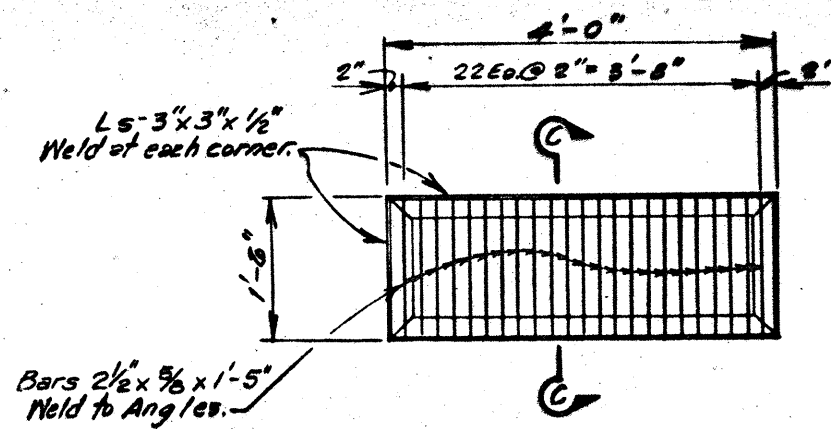






GRATE - TYPE 2

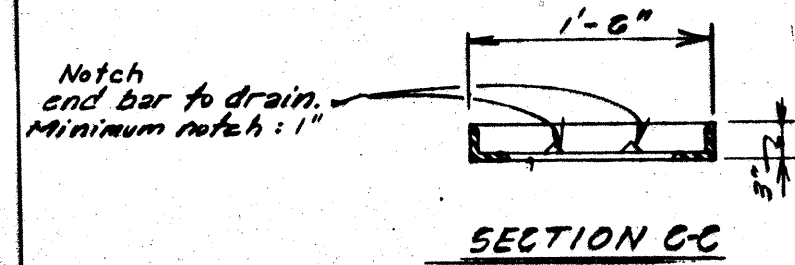

Dale R. Stein, Jr. Oct 31, 82

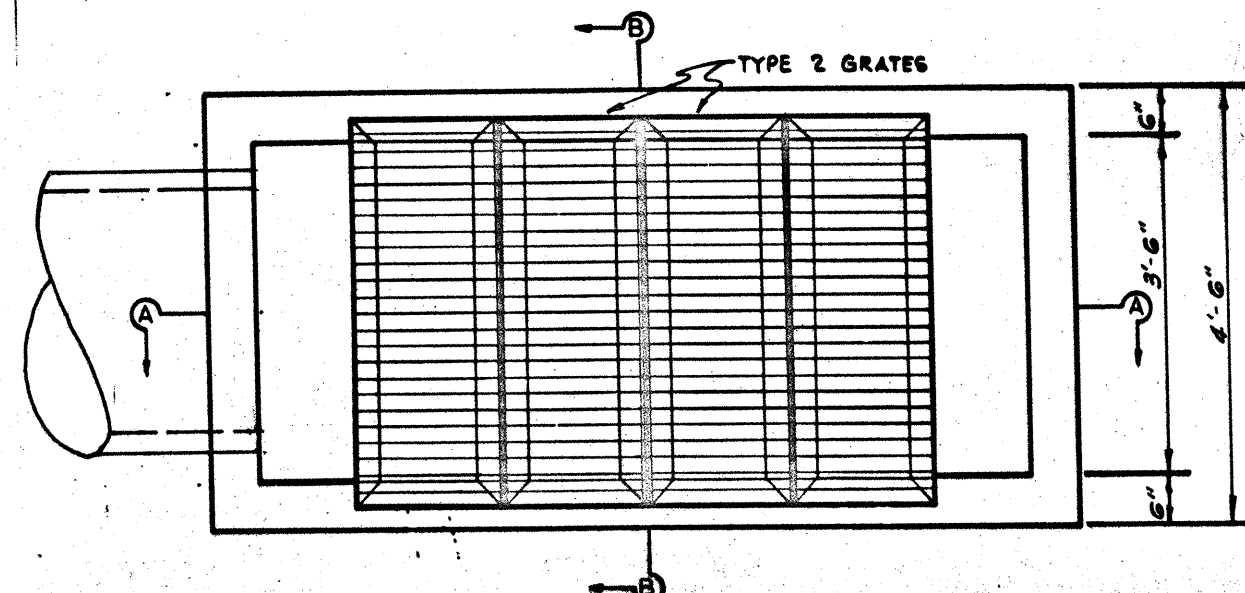

REINFORCING STEEL					
Bar	No.	Size	Spacing	Length	Weight
A	13	#4	9"±	8'-2"	71
S	5	#4	9"±	11'-6"	38
T	32	#4	9"±	Varies	Varies
U	Varies	#4	9"±	8'-2"	Varies
V	Varies	#4	9"±	6'-10"	Varies

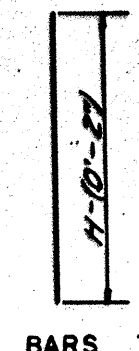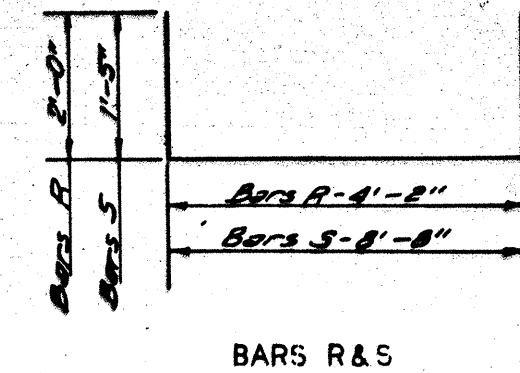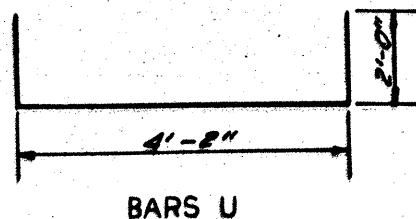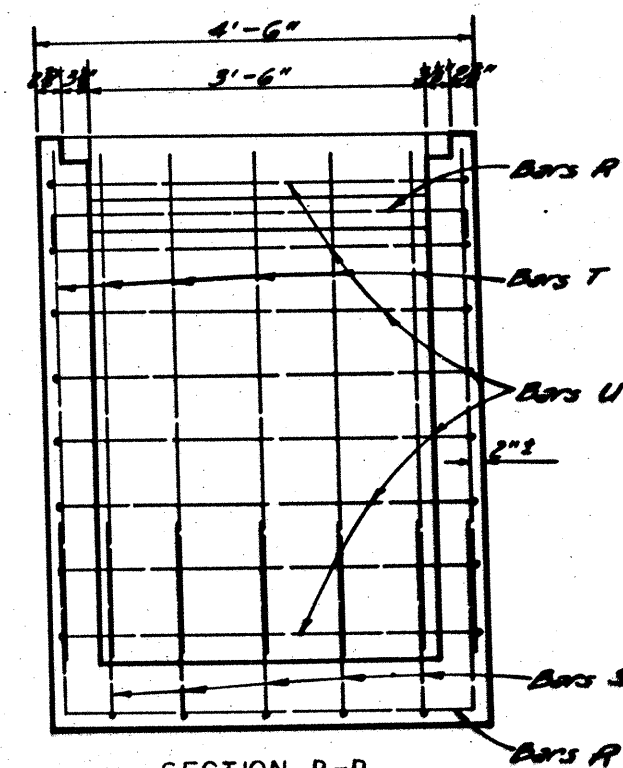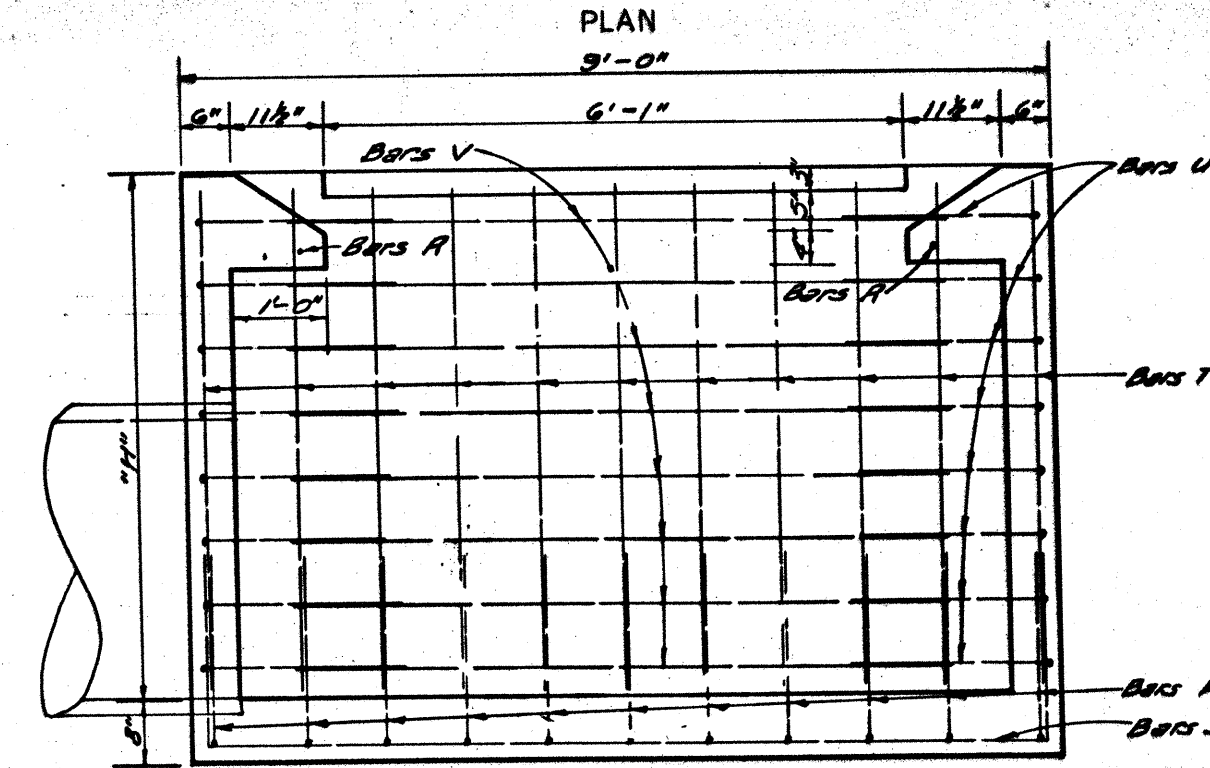

DROP INLET DETAILS


DROP INLET TYPE 6


PROJECT NO.	STATE	FEDERAL PROJECT NO.	SHEET NO.
15	ILL.	IR35-2(199)171	10
DATE	BY	CHECKED	APPROVED
10/27/82	PEXAR	10/27/82	10/27/82

10

ESTIMATED QUANTITY		
ITEM	QUANT	UNIT
Abbreviated Pav Mark (White)	243	LF
Jiggle Bar Tile (Ty W)	275	E2
Pav. Mark (Reflect) (Ty II CR)	105	E2
Constr Pav Mark (Non-Remov) (4 in) (W) Solid	2500	LF
Constr Pav Mark (Non-Remov) (4 in) (Y) Solid	2020	LF
Constr Pav Mark (Non-Remov) (4 in) (W) Broken	320	LF
Temp Flex-Reflect Rdwy Mkr/Tabs (Ty W)	33	E2
Retr Prefab Pav Mark (24 in) (White) Solid	24	LF
Pav. Mark (Reflect) (Ty IC)	53	E2

NOTE:  
 Jiggle bars shall be placed on 40' centers.  
 Pav. Mark (Reflect) (Ty II CR) shall be placed  
 on 20' centers.  
 For further details on pavement markings  
 see sheets No. 12, 13 and 14.

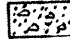 This area to receive a one  
 course surface treatment  
 to eliminate existing  
 pavement markings. To  
 be paid for Under Item  
 320.




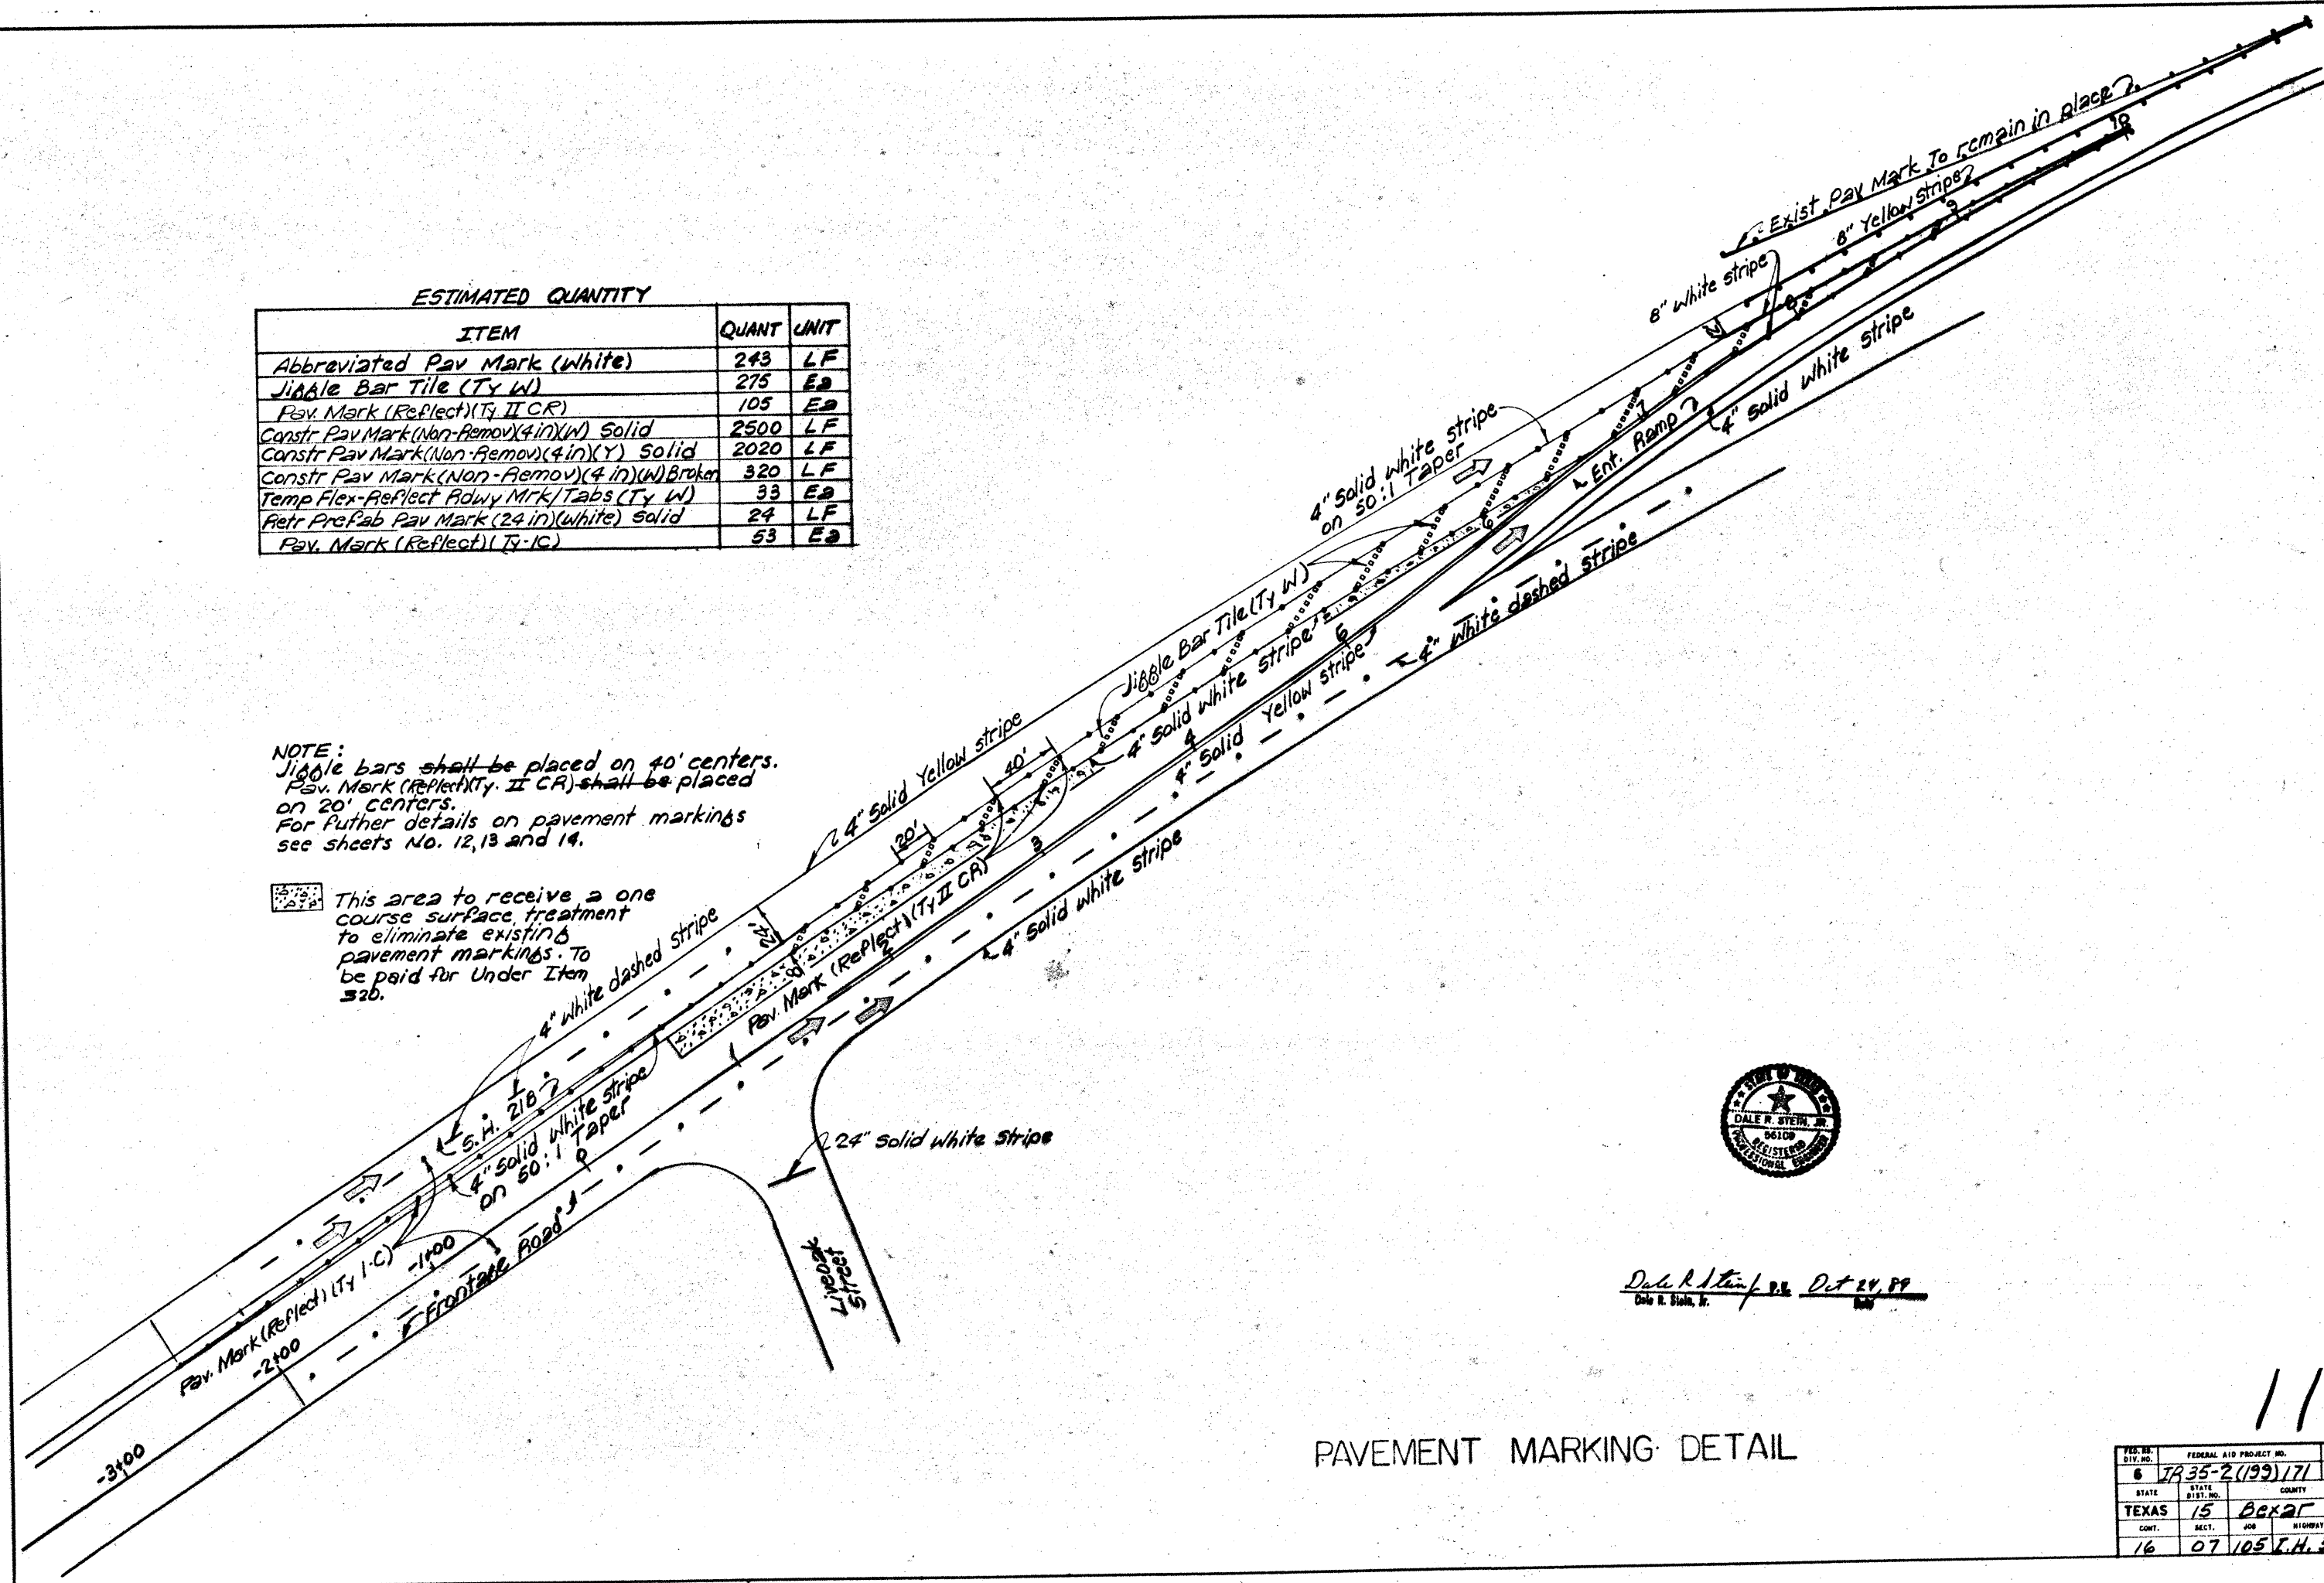


Dale R. Stein, P.E. Oct 24, 89  
 Dale R. Stein, P.E.





## PAVEMENT MARKING DETAIL

FED. RD. DIV. NO.	FEDERAL AID PROJECT NO.	SHEET NO.
6	TR 35-2(199) 171	11
STATE	DIST. NO.	COUNTY
TEXAS	15	BEXAR
CONT.	SECT.	JOB
16	07	105 I.H. 35



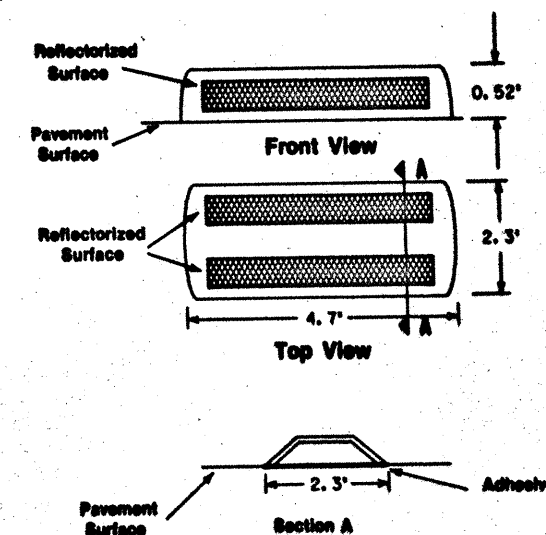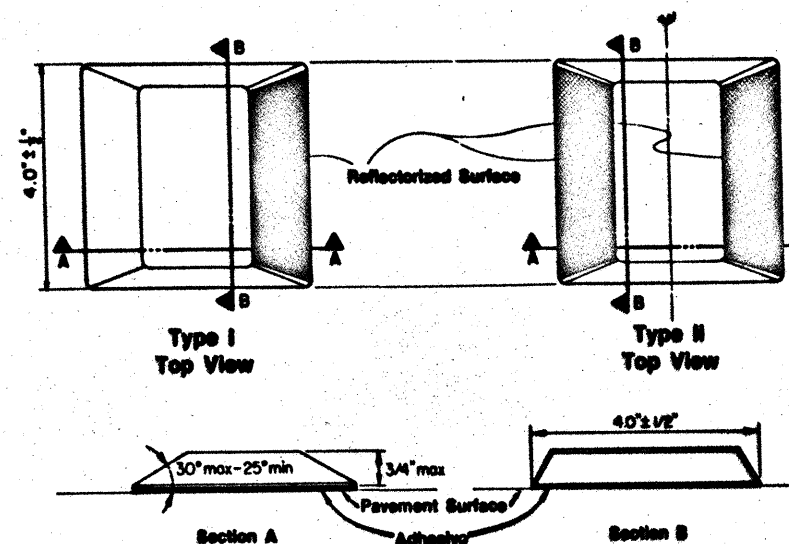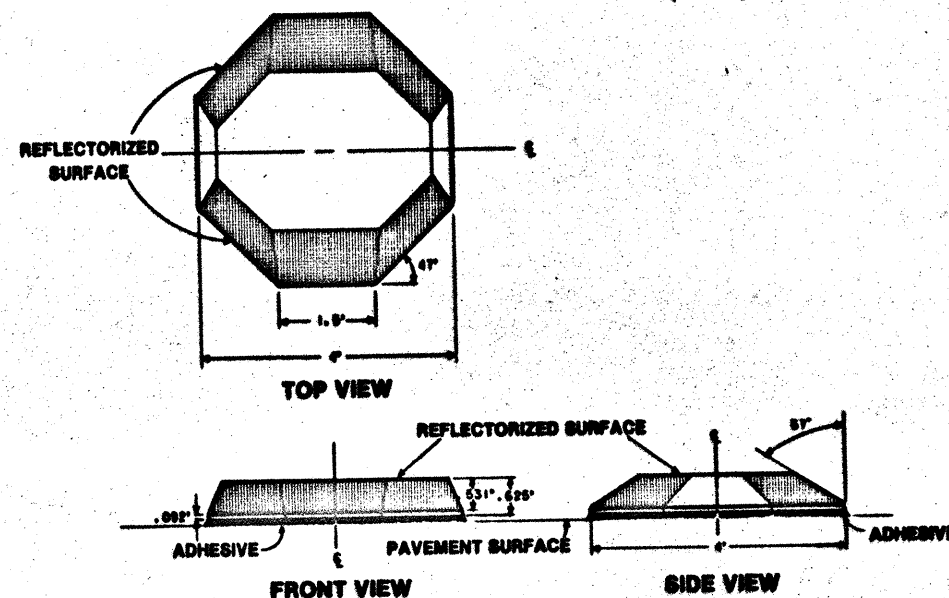
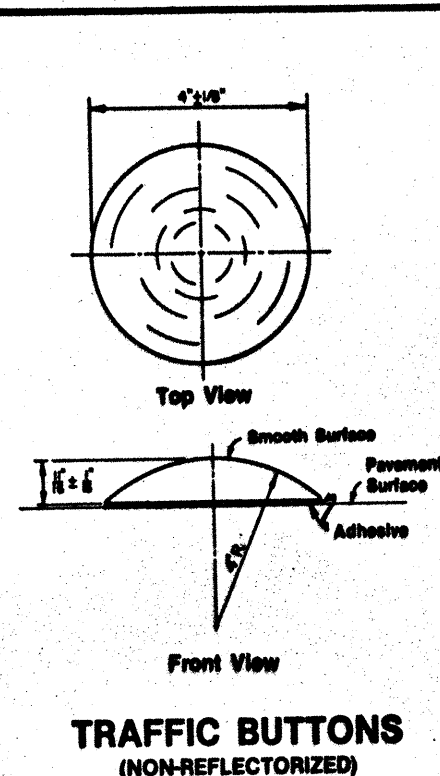


## PAVEMENT MARKERS (REFLECTORIZED)

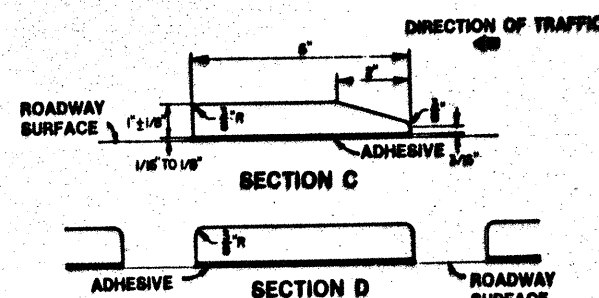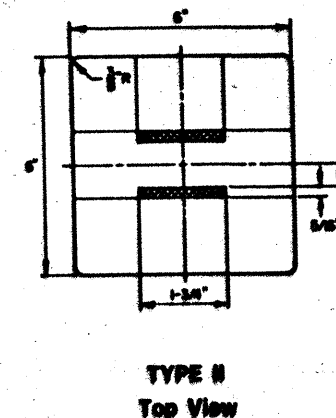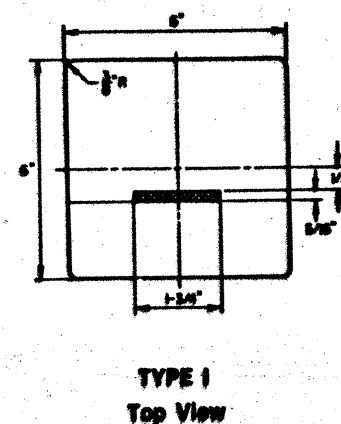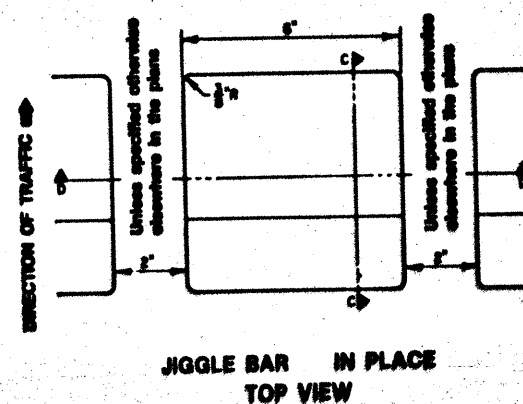


## JIGGLE BAR TILES (NONREFLECTIVE)

"JIGGLE BARS" CONSIST OF A NUMBER OF JIGGLE  
 BAR TILES PLACED IN A LINEAR CONFIGURATION

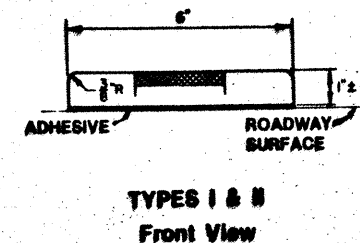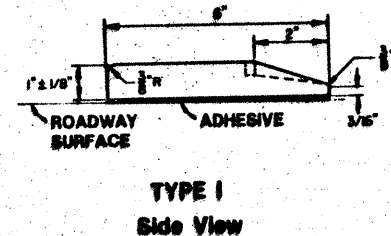

## JIGGLE BAR TILES (REFLECTORIZED)

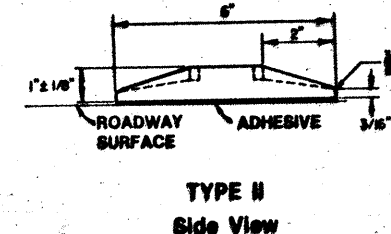

**NOTE**  
 ALL DIMENSIONS ARE ± 1/8" UNLESS  
 OTHERWISE SHOWN

### GENERAL NOTES:

THE PAVEMENT UPON WHICH THE TRAFFIC BUTTONS, PAVEMENT MARKERS, AND JIGGLE BAR TILE ARE TO BE PLACED SHALL BE PREPARED SUBJECT TO THE APPROVAL OF THE ENGINEER TO INSURE PROPER CLEANING OF THE PAVEMENT SURFACE. RPM'S SHALL BE BONDED TO THE ROADWAY SURFACE WITH ADHESIVE CONFORMING WITH SPECIFICATION.

UNLESS SPECIFIED ELSEWHERE IN THE PLANS, THE USUAL JIGGLE BAR SPACING IS 50' ON MEDIAN PAVED SHOULDERS, 100' ON OUTSIDE PAVED SHOULDERS. JIGGLE BARS SHALL BE ORIENTED PERPENDICULAR TO THE ROADWAY.

JIGGLE BARS SHALL ALSO BE PLACED AT SUCH OTHER LOCATIONS AS SHOWN ON THE PLAN AND PROFILE SHEETS OR WHERE DIRECTED BY THE ENGINEER.

MARKERS SHOWN ARE FOR ILLUSTRATION PURPOSES ONLY. THEY ARE NOT INTENDED TO SPECIFY ANY PARTICULAR PRODUCT.

1. TYPE OF PAVEMENT MARKERS (REFLECTORIZED) PROVIDED ON THIS PROJECT WILL BE AT THE CONTRACTOR'S OPTION.
2. ALL PAVEMENT MARKERS PROVIDED SHALL BE OF THE SAME MANUFACTURER.





STATE DEPARTMENT OF HIGHWAYS  
 AND PUBLIC TRANSPORTATION

INDIVIDUAL UNIT PAVEMENT MARKINGS  
 REFLECTIVE PAVEMENT MARKERS,  
 TRAFFIC BUTTONS &  
 JIGGLE BAR TILE

IPM(1)

ORIGINAL DRAWING DATE	1-81	STATE DISTRICT	15	FEDERAL SECTION	6	PERSONAL AID PROJECT	TR 35-2 (199) 171	SHEET	12
CL. 1	2-82	7-86	CL. 2	7-85	10-86	COUNTY	BEXAR	SECTION	1b
CL. 3	11-85		CL. 4			SECTION	7	JOB	105
						SECTION	7	JOB	105


21A

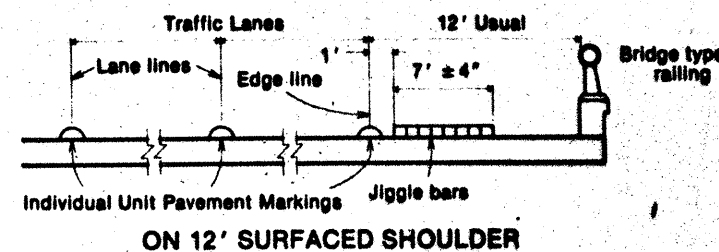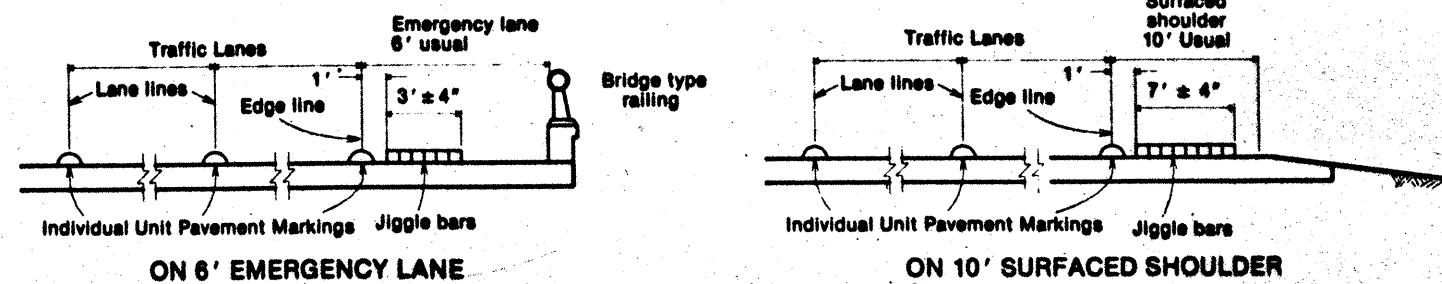


### TYPICAL SECTIONS SHOWING INDIVIDUAL UNIT PAVEMENT MARKINGS & JIGGLE BAR LOCATIONS

(INDIVIDUAL UNIT PAVEMENT MARKING EDGE LINES NORMALLY USED ONLY WITH EMERGENCY LANES)


LANE LINES AND EDGE LINES MAY CONSIST OF VARIOUS MATERIALS AS CALLED FOR ELSEWHERE IN THE PLANS. JIGGLE BAR TILES USED ON EMERGENCY LANE OR SURFACED SHOULDER ARE PLACED TO REDUCE ACCIDENT POTENTIAL ASSOCIATED WITH SINGLE VEHICLE, RUN-OFF-ROAD TYPE ACCIDENTS.

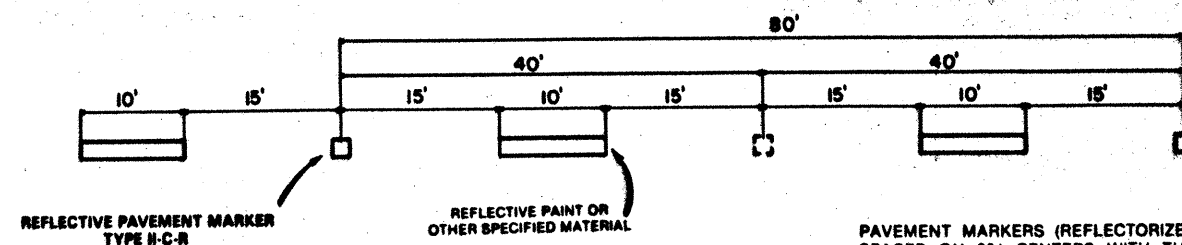


PAVEMENT MARKERS (REFLECTORIZED) TYPE II-C-R SHALL BE SPACED ON 80' CENTERS WITH THE CLEAR FACE TOWARD NORMAL TRAFFIC AND THE RED FACE TOWARD WRONG WAY TRAFFIC. SPACING MAY ALSO BE ON EITHER 40' OR 160' CENTERS WHEN SHOWN ELSEWHERE IN THE PLANS.

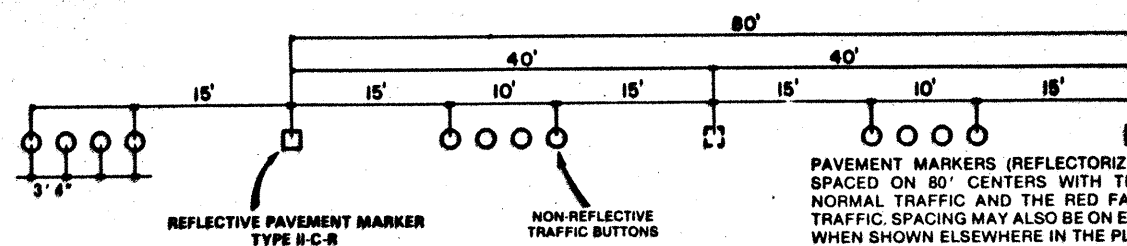

### TRAFFIC LANE LINES PAVEMENT MARKING DETAILS

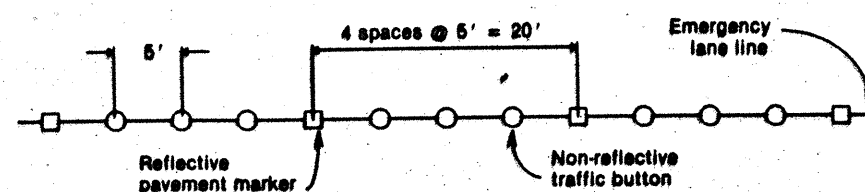


### TRAFFIC BUTTONS FOR EMERGENCY LANE & SHOULDER EDGE LINES

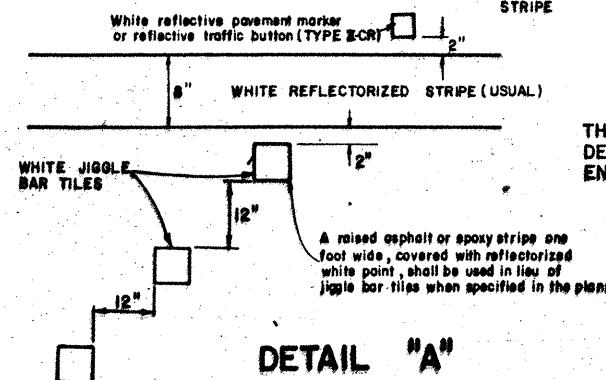

DETAIL "A"


A raised asphalt or epoxy stripe one foot wide, covered with reflectORIZED white paint, shall be used in lieu of jiggle bar tiles when specified in the plans.

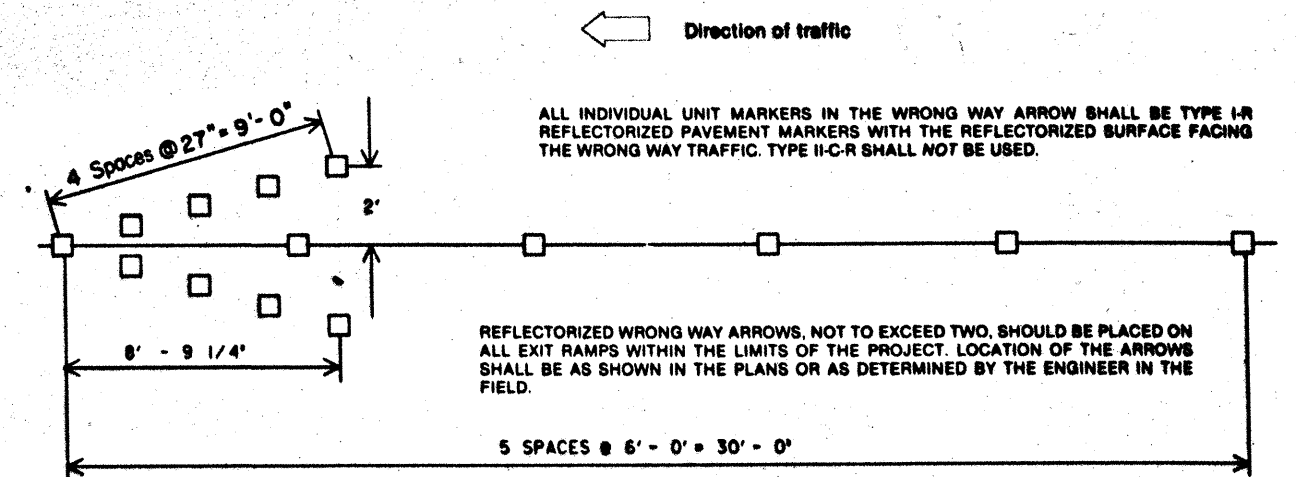


ALL INDIVIDUAL UNIT MARKERS IN THE WRONG WAY ARROW SHALL BE TYPE I-R REFLECTORIZED PAVEMENT MARKERS WITH THE REFLECTORIZED SURFACE FACING THE WRONG WAY TRAFFIC. TYPE II-C-R SHALL NOT BE USED.

REFLECTORIZED WRONG WAY ARROWS, NOT TO EXCEED TWO, SHOULD BE PLACED ON ALL EXIT RAMP WITHIN THE LIMITS OF THE PROJECT. LOCATION OF THE ARROWS SHALL BE AS SHOWN IN THE PLANS OR AS DETERMINED BY THE ENGINEER IN THE FIELD.

### WRONG WAY ARROW DETAIL

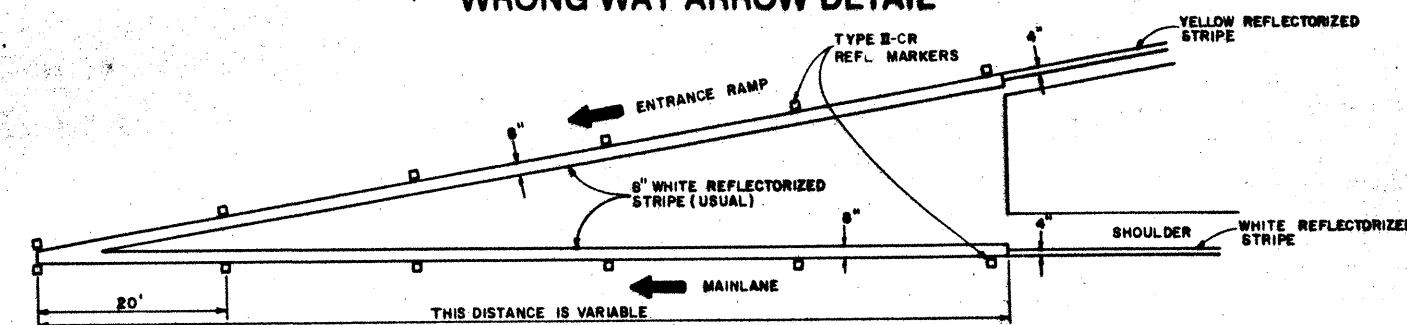

### TYPICAL ENTRANCE RAMP GORE MARKING

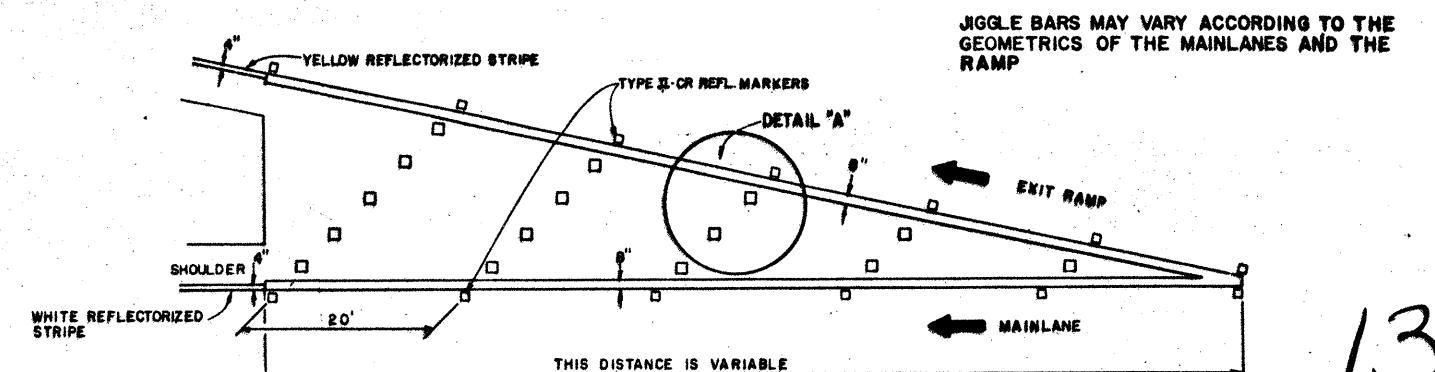

JIGGLE BARS MAY VARY ACCORDING TO THE GEOMETRICS OF THE MAINLANES AND THE RAMP

### TYPICAL EXIT RAMP GORE MARKING


THE SHAPE OF THE GORE MARKING WILL VARY DEPENDING ON THE RAMP DESIGN AND WILL BE AS SHOWN IN THE PLANS OR AS DIRECTED BY THE ENGINEER.



Patrick L. Irwin 12-05-88 Date


STATE DEPARTMENT OF HIGHWAYS AND PUBLIC TRANSPORTATION			
INDIVIDUAL UNIT PAVEMENT MARKINGS, REFLECTIVE PAVEMENT MARKERS, TRAFFIC BUTTONS, & JIGGLE BARS FOR FREEWAYS			
IPM(2)(MOD)			
DRAWING DATE 5-74	STATE OF TEXAS	FEDERAL AID PROJECT	DATE
7-86	15	6	12-05-88
2-88	16	7	12-05-88
6-88	16	7	12-05-88

2-88 - ADDED ENTRANCE RAMP DETAIL

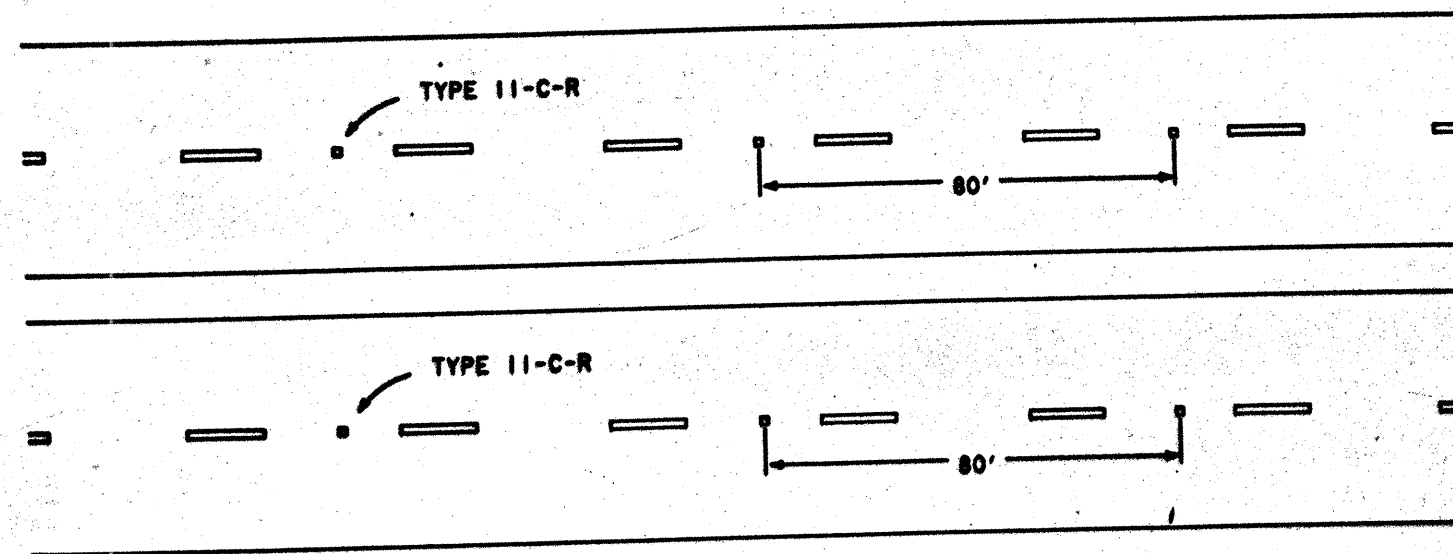


### LANE LINES FOR DIVIDED HIGHWAYS

INDIVIDUAL UNIT MARKER TYPE II-C-R, CLEAR FACE TOWARD NORMAL TRAFFIC AND RED FACE TOWARD WRONG-WAY TRAFFIC, SHALL BE SPACED ON 80-FOOT CENTERS EXCEPT ON VERTICAL CURVES, GRADES OVER 2 PER CENT, LESS THAN 1000 FEET LONG, HORIZONTAL CURVES, AND ON CONTINUOUSLY ILLUMINATED SECTIONS OF HIGHWAY WHERE THEY MAY BE PLACED ON 40-FOOT CENTERS IF DEEMED NECESSARY BY THE ENGINEER.

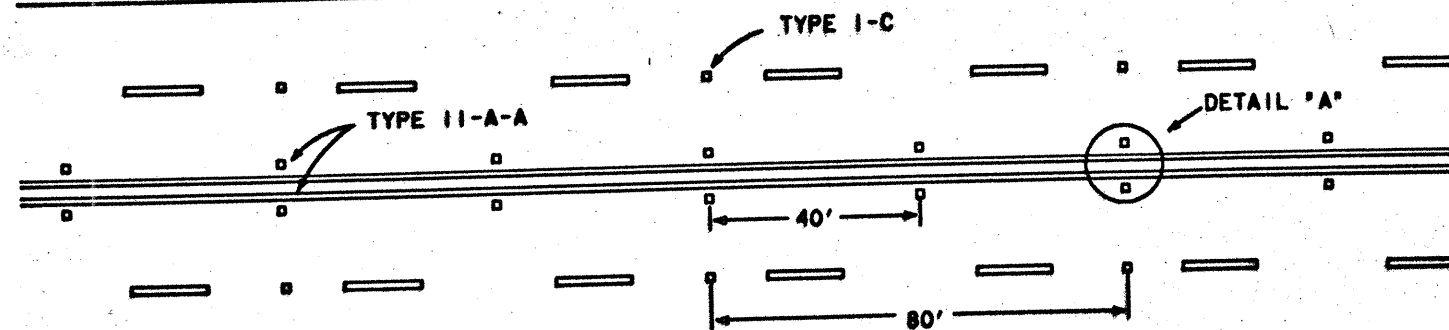


### LANE LINES & CENTER LINES FOR MULTI-LANE UNDIVIDED HIGHWAYS


INDIVIDUAL UNIT MARKER TYPE I-C, CLEAR FACE TOWARD NORMAL TRAFFIC, SHALL BE PLACED ON 80-FOOT CENTERS.

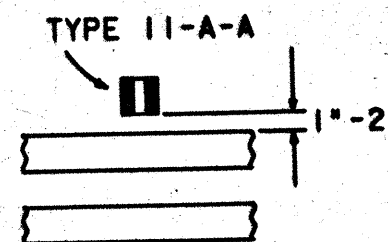

DETAIL 'D'

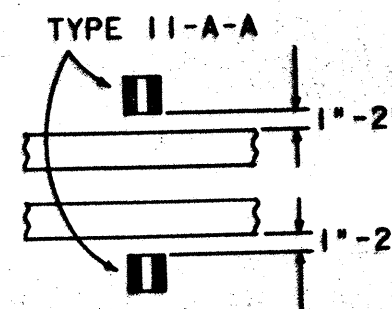

DETAIL 'A'

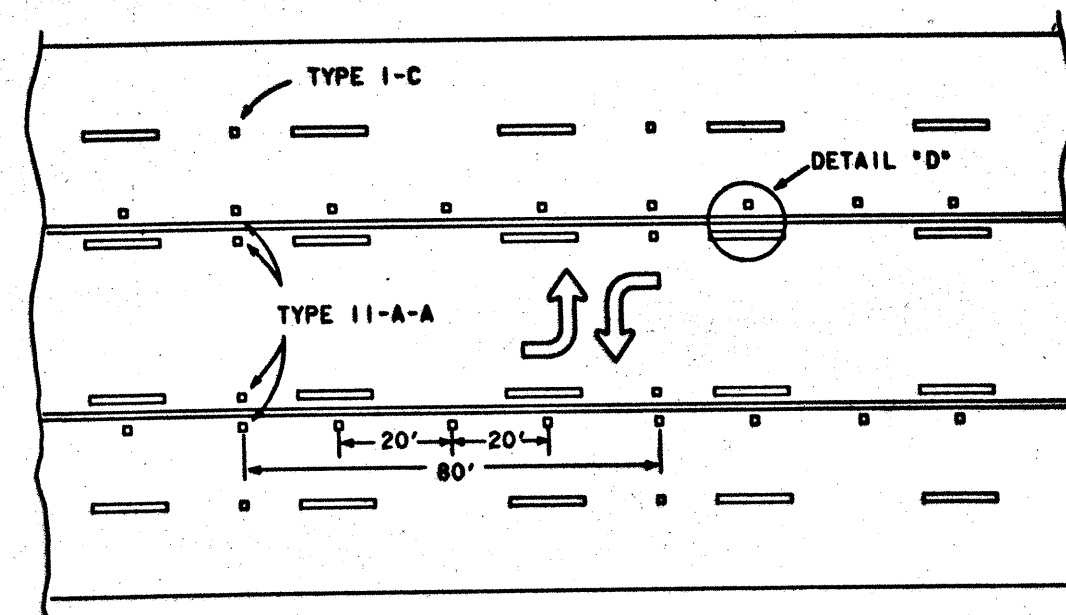

### PAVEMENT MARKINGS FOR TWO-WAY LEFT TURN LANE



*Patrick L. Smith* 08-29-89  
PAVED, L. Smith


#### GENERAL NOTES:

ALL INDIVIDUAL UNIT MARKERS PLACED IN DASHED LINES SHALL BE PLACED IN LINE WITH AND MIDWAY BETWEEN THE STRIPES.

FIRST AND LAST INDIVIDUAL UNIT MARKERS IN A NO-PASSING ZONE BARRIER LINE ARE TO BE LOCATED ADJACENT TO EITHER THE MIDPOINT OF THE GAP OF THE CENTERLINE MARKING OR TO THE MIDPOINT OF THE STRIPE OF THE CENTERLINE MARKING.

ADDED CONDITION TWO FOR ROADWAYS 22' OR LESS IN WIDTH.


### CENTER LINE & NO PASSING ZONE BARRIER LINES FOR TWO-LANE TWO-WAY HIGHWAYS

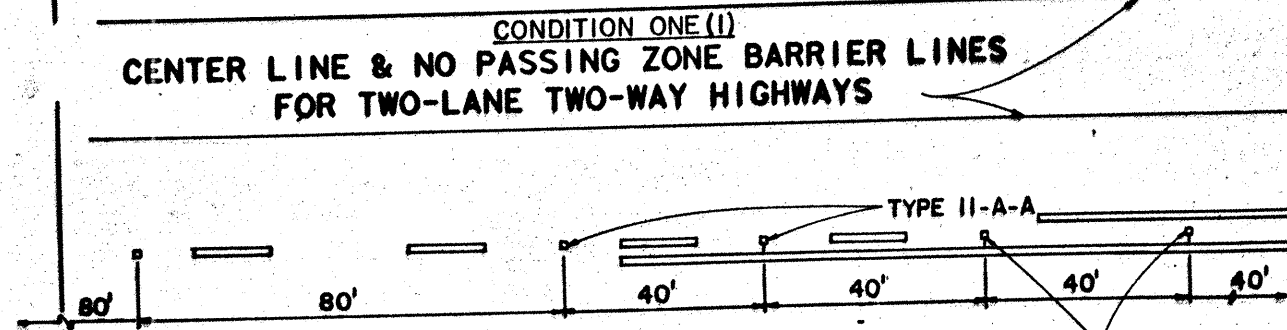


GENERAL NOTES:  
CONDITION TWO(2) SHOULD BE USED  
FOR ROADWAYS 22' OR LESS IN WIDTH.

#### CONDITION TWO(2)

TYPE II-A-A MAY BE PLACED  
AT 40-FOOT CENTERS ON THE  
CENTER LINE ADJACENT TO NO PASSING  
ZONES FOR EITHER LANE AND AT LOCATIONS  
DEEMED NECESSARY BY THE ENGINEER.

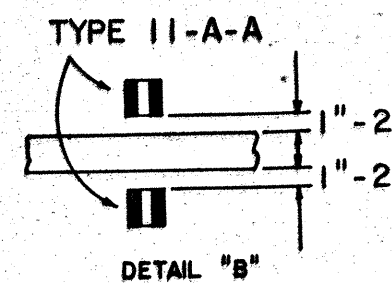

DETAIL 'B'

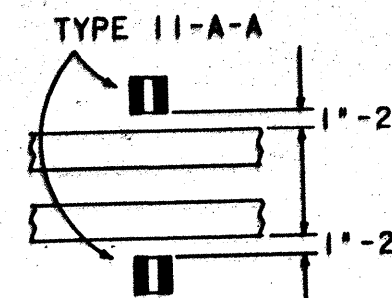

DETAIL 'C'



STATE DEPARTMENT OF HIGHWAYS  
AND PUBLIC TRANSPORTATION

INDIVIDUAL UNIT PAVEMENT  
MARKINGS USED WITH  
STANDARD PAVEMENT MARKINGS FOR  
CENTER LINES AND LANE LINES

PM(2XMOD)(DIST.15)


REV. 8-29-89

DATE	REVISION	BY	CHKD	APP'D
6	TR 35-2(1991)7	14		
REVISOR	16	7	105	14



# WORK ZONE PAVEMENT MARKINGS

## Raised Markers

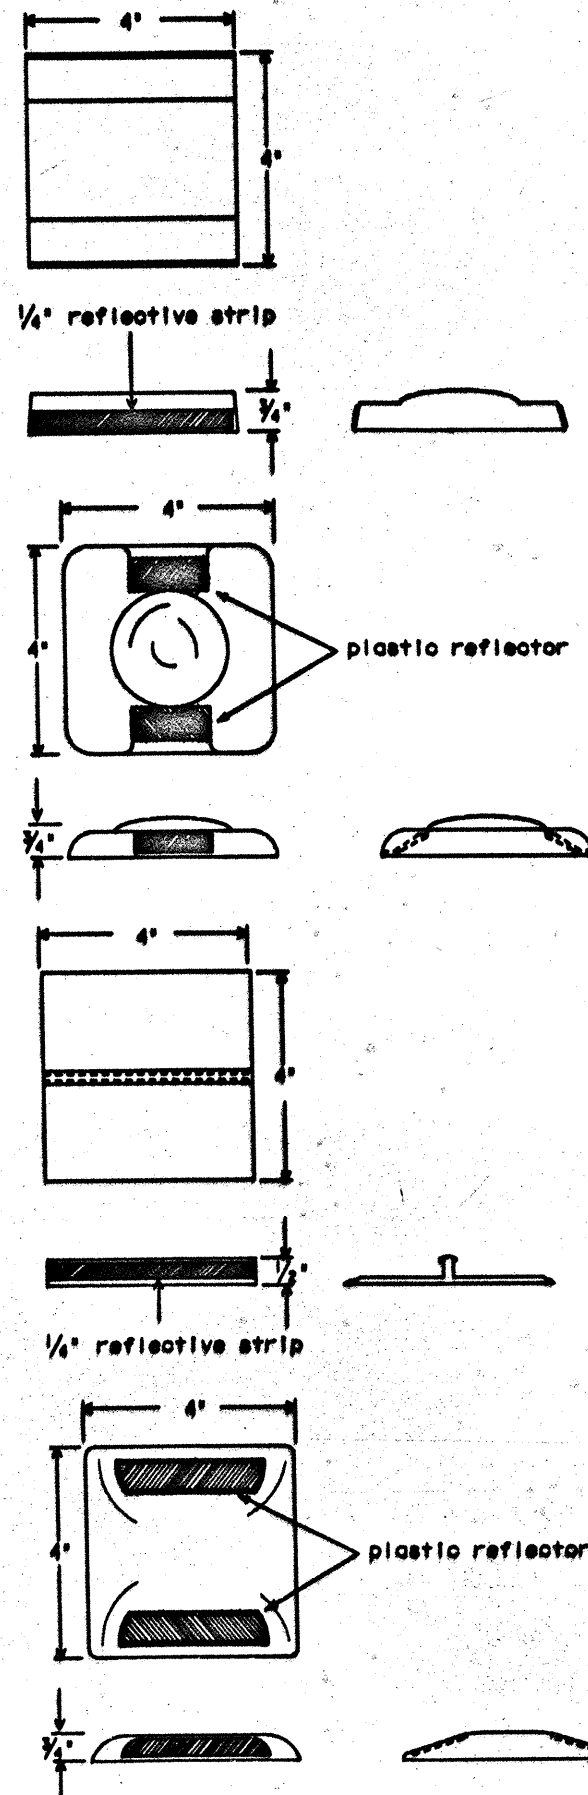

## NOTES FOR WORK ZONE PAVEMENT MARKINGS

### GENERAL

- 1) Dimensions indicated on this sheet are typical and approximate. Variations in size and height may occur between markers or devices made by manufacturers, by as much as 1/4 inch, unless otherwise noted.
- 2) This sheet is to be used in conjunction with Standard Sheet TCP(5-2).
- 3) Raised markers and temporary flexible-reflective roadway marker tabs will require normal maintenance replacement when used on roadways with an ADT per lane of up to 7500 vehicles with no more than 10% truck mix. When roadways exceed these values additional maintenance replacement of devices should be planned, or permanent individual unit pavement markings used, as detailed on sheets IPM(1), IPM(2), PM(0), PM(1), PM(2), PM(3) or as detailed elsewhere in the plans.

### RAISED MARKERS

#### General

- 1) Raised Markers detailed on this sheet will be designated Type AA (two amber reflective surfaces with yellow body), Type A (one amber reflective surface with yellow body) or Type C (one silver reflective surface with white body). Color used shall be in accordance with the TMUTCD.

#### Sampling & Testing

- 1) Pavement Markings detailed on this sheet are to be inspected and accepted by the Project Engineer or his designated representative. Sampling and testing is not normally required.

### ABBREVIATED PAVEMENT MARKINGS

#### General

- 1) Temporary flexible-reflective roadway marker tabs detailed on this sheet will be designated Type Y-2 (two amber reflective surfaces with yellow body), Type Y (one amber reflective surface with yellow body), and Type W (one silver reflective surface with white body).

#### Material

- 1) Temporary flexible-reflective roadway marker tabs shall meet requirements of Department Material Specification D-9-8242.
- 2) The body of the temporary flexible-reflective roadway marker tabs shall consist of a base and vertical wall made of polyurethane, polyester elastomer or other material approved by the Materials and Tests Division.
- 3) The reflective material shall be protected with an easily removable heat resistant transparent cover capable of withstanding and protecting the reflective material from the application of 400 degree F asphalt. Stapling or clipping devices used to retain the protective cover shall not protrude through the reflective material.

#### Sampling & Testing

- 1) Temporary flexible-reflective roadway marker tabs for seal coat projects detailed on this sheet are to be inspected and accepted by the Project Engineer or his designated representative. Sampling and testing is not normally required, however at the option of the Engineer, either "A" or "B" below may be imposed to assure quality before placement on the roadway.
  - A) Select five (5) or more temporary flexible-reflective roadway marker tabs at random from each lot or shipment and submit to the Materials and Tests Division to determine specification compliance.
  - B) Select five (5) temporary flexible-reflective roadway marker tabs and submit to the following test. Affix five (5) tabs at two (2) foot intervals on an asphaltic pavement in a straight line. Using a medium size sedan, run over the markers with front and rear wheels at a speed of 35 to 40 miles per hour, four times in each direction. No more than one (1) out of five reflective surfaces shall be lost or displaced as a result of this test.

#### Maintenance

- 1) When dry, the temporary flexible-reflective roadway marker tabs shall be visible for a minimum distance of 200 feet during normal daylight hours and when illuminated by automobile low-beam head light at night, unless sight distance is restricted by roadway geometrics.
- 2) No two consecutive tabs nor four tabs per 1000 feet of line shall be missing or fail to meet the visual performance requirements of note 1.
- 3) The Contractor will be responsible for maintaining the abbreviated pavement markings, when they are used, until the standard pavement markings are in place. When the Contractor is responsible for placement of the standard pavement markings, no segment of roadway shall remain without standard pavement markings for a period greater than two (2) weeks unless weather conditions prohibit that placement. The standard pavement markings shall be placed as soon as weather permits.
- 4) After 72 hours following the seal-coat operation, provided the standard pavement markings have not been placed, any temporary flexible-reflective roadway marker tabs not meeting the visibility requirements stated in note 1, shall be replaced as directed by the Engineer.

### REMOVABLE - PREFABRICATED PAVEMENT MARKINGS

#### Sampling & Testing

- 1) Removable - Prefabricated Pavement Markings shall be a material of manufacture and product code or designation shown on the list of approved materials covered by the Department Materials Specification D-9-8241. The list of approved materials will be maintained by the Equipment and Procurement Division (File D-4).


### CONSTRUCTION GRADE - PREFABRICATED PAVEMENT MARKINGS (FOIL BACK)

#### Sampling & Testing

- 1) Construction Grade - Prefabricated Pavement Markings shall be a material of manufacture and product code or designation shown on the list of approved material covered by the Specification SDHPT - 550-74-01. The list of approved materials will be maintained by the Equipment and Procurement Division (File D-4).

# WORK ZONE PAVEMENT MARKINGS

## Temporary Flexible-Reflective Roadway Marker Tabs for Seal Coat Projects

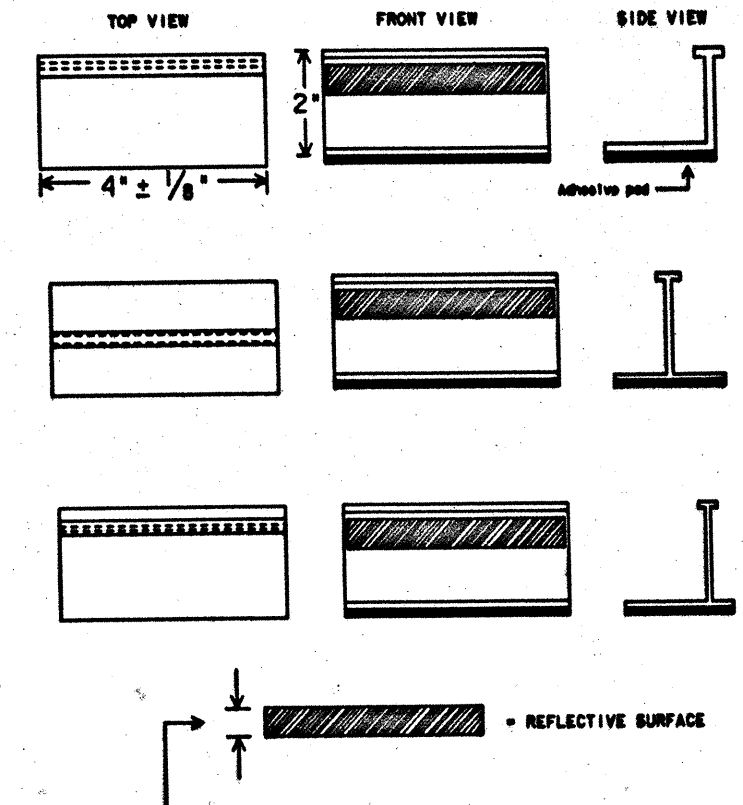

Height of sheeting will be determined by Note 1 under Maintenance of ABBREVIATED PAVEMENT MARKINGS. Usually more than .2 inch and less than 1 inch.

STATE DEPARTMENT OF HIGHWAYS  
AND PUBLIC TRANSPORTATION  
  
Work Zone  
Pavement Markings

TCP (5-1)

5/88		REV. NO.	STATE	FEDERAL AID PROJECT NO.		STATION NO.	
DRAWN	DN	6	TEXAS	IR 35-2(195) 171		1H 85	
CHECKED	LR	STATE DIST. NO.	COUNTY	CONTROL	SECTION	JOB NO.	SHEET NO.
TRACED		15	BEXAR	16	7	105	15
CHECKED							

Questions: Dick Walworth 258-8337

Full Scale Plot Ratio 1201

East 12 Inches. 10000


100


1. The first step in the process is to identify the problem or issue that needs to be addressed. This involves gathering information and understanding the context of the problem.


**SOLID  
LINES**

DOUBLE  
NO PASSING  
LINE

**ZONE PAVEMENT MARKINGS**

**RAISED MARKERS** 4' to 12'  5' ± 3' Type AA

**PAINT & BEAD** 4' to 12'  4' Yellow

\* **ABBREVIATED MARKINGS** 4' to 12'  Yellow

EDGE LINE  
OR SINGLE  
NO PASSING LINE

Diagram illustrating the layout of a road marking:

- RAISED MARKERS:** A series of markers along the top edge, with dimensions  $6' 3"$  and  $4"$  indicated. An arrow points to a marker labeled "Type C or AA".
- PAINT & BEAD:** A horizontal line below the markers, with a dimension of  $4"$  indicated. An arrow points to the line labeled "White or Yellow".

WIDE  
LINE

Diagram illustrating a wide line with raised markers and paint & bead. The diagram shows a series of raised markers (Type C) spaced at 1'-2" intervals. The markers are labeled "Type C" and "5' ± 3". The line is labeled "WIDE LINE" and "PAINT & BEAD". The diagram also shows a "Type C" marker and a "5' ± 3" dimension. The line is labeled "WIDE LINE" and "PAINT & BEAD". The diagram also shows a "Type C" marker and a "5' ± 3" dimension. The line is labeled "WIDE LINE" and "PAINT & BEAD".

**BROKEN  
LINE**

(FOR CENTER LINE  
OR LANE LINE.)

**RAISED MARKERS**

Diagram showing a sequence of markers: a square marker, followed by a 10' distance, then another square marker, followed by a 30' distance, then a third square marker. A label "Type C or AA" points to the third marker. To the right, a separate diagram shows three square markers in a row with a dimension of  $3' - 4' \pm 3''$ .

**PAINT & DEAD**

Diagram showing a sequence of markers: a rectangular marker, followed by a 10' distance, then a square marker, followed by a 30' distance, then another square marker. A label "Optional Type C or AA" points to the second square marker. To the right, a separate diagram shows a rectangular marker with a label "White or Yellow" pointing to it.

**ABBREVIATED MARKINGS**

Diagram showing a sequence of markers: a rectangular marker, followed by a 40' ± 1' distance, then a square marker, followed by a 4.5' ± 6" distance, then another rectangular marker. A label "White or Yellow" points to the square marker. To the right, a separate diagram shows a rectangular marker with a label "White or Yellow" pointing to it.

### ABBREVIATED PAVEMENT MARKING DETAILS

The diagram illustrates various temporary flexible-reflective roadway marker tabs and their applications:

- STICK DOWN TAPE:** Shows a single tab with a width of  $4.5' \pm 6"$  and a spacing of  $40' \pm 1'$ . An optional raised marker is also shown with a spacing of  $40' \pm 1'$ .
- RAISED PAVEMENT MARKERS:** Shows two types: Type C or Type AA with a width of  $4.5' \pm 6"$  and a spacing of  $40' \pm 1'$ , and a smaller tab with a width of  $2' \pm 4"$ .
- TEMPORARY FLEXIBLE-REFLECTIVE ROADWAY MARKER TABS:**
  - Standard pavement markings to be placed within two weeks after temporary flexible-reflective roadway marker tabs.
  - For seal coat projects only.
  - Point & Bead.
  - Standard markings include a  $40' \pm 1'$  spacing and a  $10'$  spacing, with a  $30'$  spacing indicated for the point and bead.
  - Temporary flexible-reflective roadway marker tabs placed to indicate beginning and end of no passing zones, are optional.
  - Type Y-2 temporary flexible-reflective roadway marker tabs.

## NOTES FOR STANDARD WORK ZONE MARKINGS

- 1) Standard Work Zone Pavement Markings may be of paint and beads, raised markers or combination of paint and raised markers; thermo plastic paint and beads may be used in lieu of paint and beads unless otherwise specified elsewhere in the plans. Abbreviated marking patterns are not to be used for standard pavement markings.
- 2) Raised markers detailed on TCP (5-1) are to be placed according to the patterns on this sheet. Standard, permanent, raised markers as detailed on sheets IPM(1) and IPM(2) shall be placed according to patterns on sheets IPM(1), IPM(2), PM(0), PM(1), PM(2) or PM(3).
- 3) For additional details on Work Zone pavement markings see sheet TCP (5-1).
- 4) Spacing for pavement markings on this sheet are maximum spacings and may be reduced to fit field conditions.
- 5) Adhesive used for work zone raised pavement markings shall be Bituminous material hot applied, or Butyl Rubber/pad.
- 6) When Channelizing line is used to discourage lane changing, edge lines should not be used unless placed next to a barrier wall.

### NOTES FOR ABBREVIATED PAVEMENT MARKINGS

- 1) Abbreviated pavement marking materials may be stick down tape, raised markers or paint and beads unless otherwise specified elsewhere in the plans.
- 2) Abbreviated pavement markings for seal coat projects shall use temporary flexible-reflective roadway marker tabs. Temporary flexible-reflective roadway marker tabs are to be installed to provide true alignment for striping crews as directed by the Engineer.
- 3) Temporary flexible-reflective roadway marker tabs for seal coat projects should be applied to the pavement no more than two days before the seal coat is applied. After the seal coat is rolled and swept the cover over the reflective strip shall be removed.
- 4) Abbreviated pavement markings shall not be used to simulate edge lines.

The diagram illustrates a two-lane sequencing gel. The top lane contains a sequence of markers labeled 'Type C' and 'Type A' from left to right. Arrows on the right side of the top lane point to the right, indicating the direction of the sequence. The bottom lane contains a similar sequence of markers labeled 'Type C' and 'Type A' from left to right. Arrows on the left side of the bottom lane point to the left, indicating the direction of the sequence. The markers are represented by dots of varying sizes, and the lanes are separated by a vertical line. The text 'RAISED MARKERS' is written at the bottom of the diagram.

Diagram illustrating a two-lane road with arrows indicating traffic flow. The road is divided into two lanes by a central line. The left lane has arrows pointing right, and the right lane has arrows pointing left. The road is labeled with 'White' and 'Yellow' sections, indicating the color of the paint used for the road markings.

EDGE & LANE LINES FOR DIVIDED HIGHWAY

White

White

Yellow

PAINT & BEAD

White

White

Yellow

ABBREVIATED MARKINGS

### LANE & CENTER LINES FOR MULTI-LANE UNDIVIDED HIGHWAYS

May also use wide line.

Type C

**RAISED MARKERS**

May also use wide line.

White

**PAINT & BEAD**

CHANNELIZING LINE TO DISCOURAGE LANE CHANGING

The diagram shows a 3D perspective of a grid of dots. The dots are arranged in a regular pattern. At the bottom, a horizontal line is labeled "RAISED MARKERS". Several arrows point to specific dots or groups of dots. Two arrows labeled "Type C" point to dots in the middle row. Two arrows labeled "Type AA" point to dots in the top row. On the left side, there are three horizontal arrows pointing right, indicating the direction of the grid's extension.

### PAVEMENT MARKINGS FOR TWO-WAY LEFT-TURN LANE

## CENTER LINE & NO-PASSING ZONE BARRIER LINES FOR TWO-LANE TWO-WAY HIGHWAYS

Diagram illustrating the layout of Pattern B raised markers. The markers are arranged in a dashed line, with a dimension of 6" to 8" indicated between the first and last markers. The markers are labeled "Type AA". Arrows indicate the direction of flow.

Diagram illustrating the sequence of paint and bead applications for Pattern A. The sequence shows a horizontal line with a yellow bead applied, followed by a 10" to 12" gap, then a paint application, and finally a yellow bead. Arrows indicate the direction of application.

10" to 12"

Yellow

PAINT & BEAD - PATTERN A

4" to 8" Yellow


PAINT & BEAD - PATTERN B

← Yellow →

\* ABBREVIATED MARKINGS














**NOTE**

- 1) Spacing between markers shall be uniform with no more than a 10% variation in spacing.
- 2) Pattern A is the Department Standard. Pattern B may be used if approved by the Engineer.
- \* 3) When abbreviated markings are used in areas of no passing zones, signs in accordance with the Texas MUTCD shall be used to indicate the limits of the no passing zones.

		STATE DEPARTMENT OF HIGHWAYS AND PUBLIC TRANSPORTATION			
WORK ZONE PAVEMENT MARKINGS MOD TCP (5-2)					
ORIGINAL DRAWING DATE: 5-88		STATE DISTRICT	FEDERAL DISTRICT	FEDERAL AID PROJECT	SHEET
CH. 1 - DN	DIVISION	15	6	2R352(199)171	16
CH. 1 - LR	1-89	COUNTY		CONTROL SECTION	IN MILES
CH. 1 -		BEXAR		16	7
CH. 1 -				105	2N 18





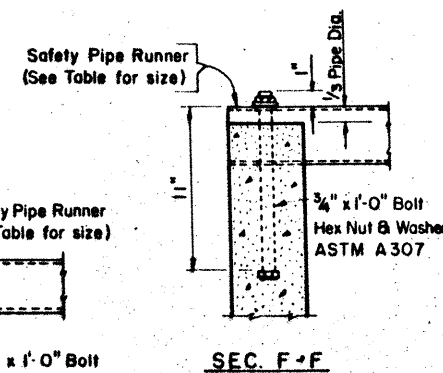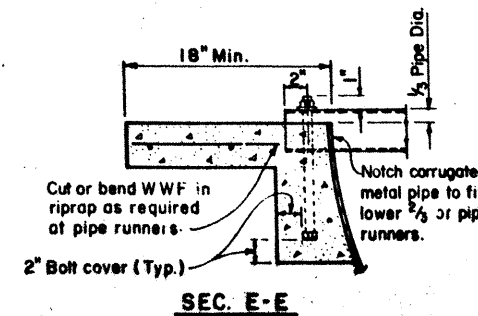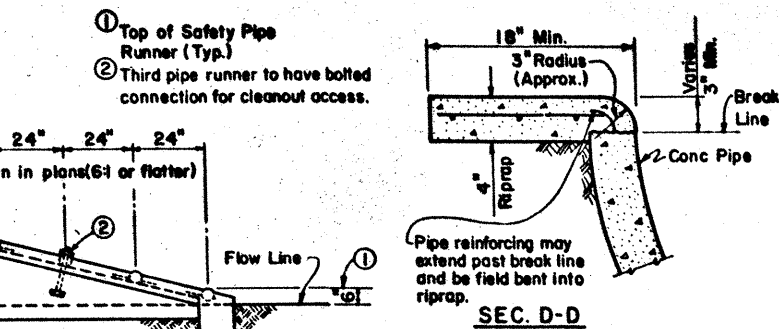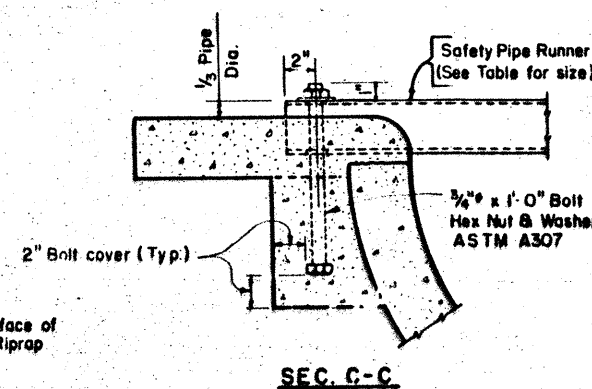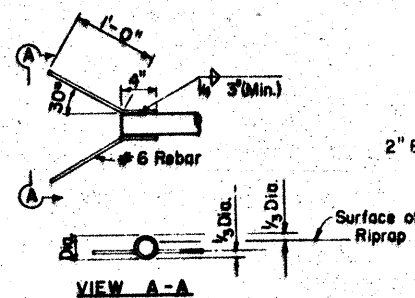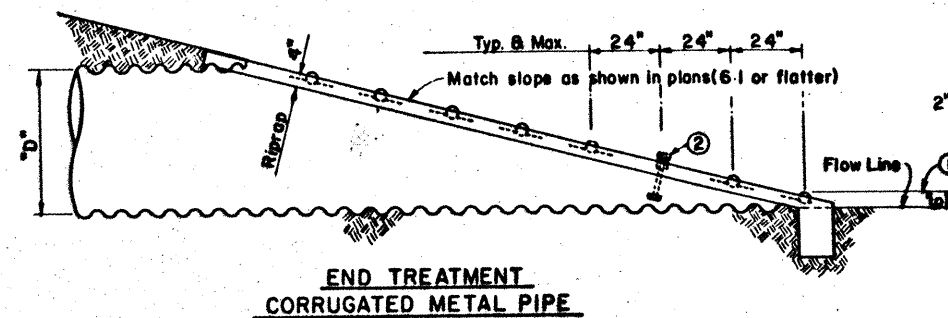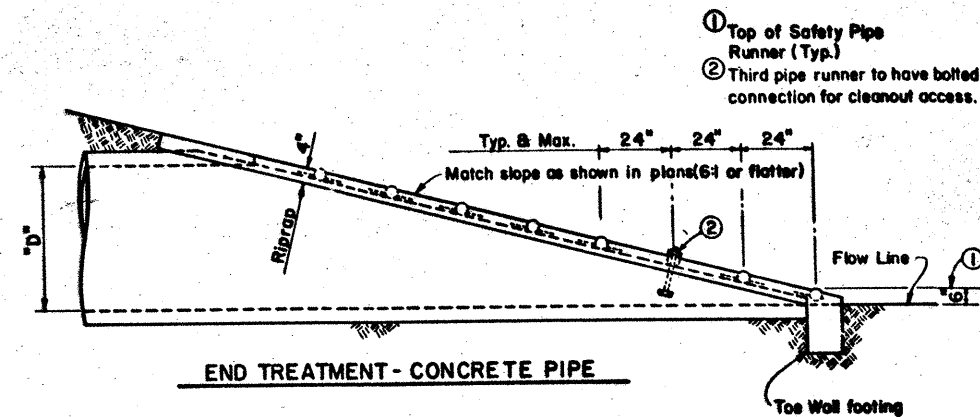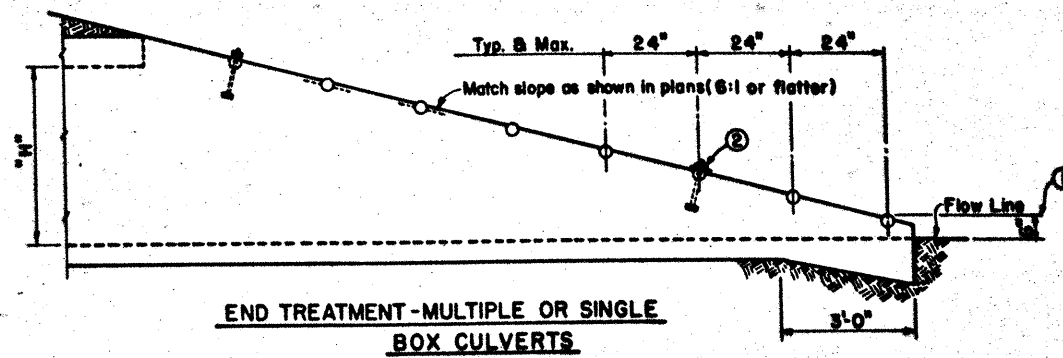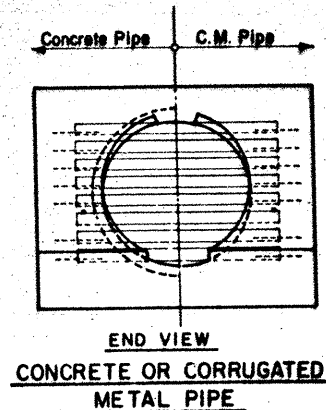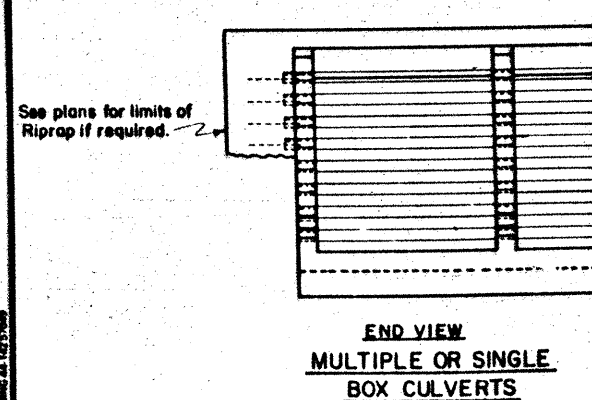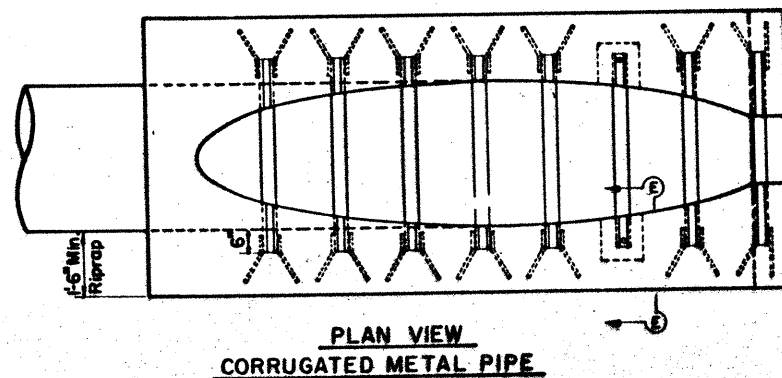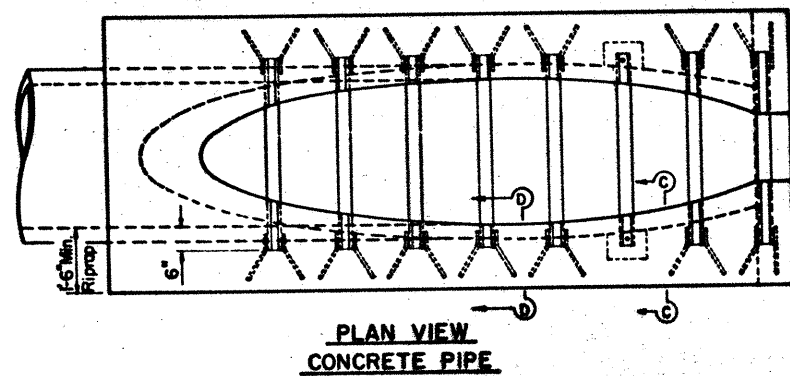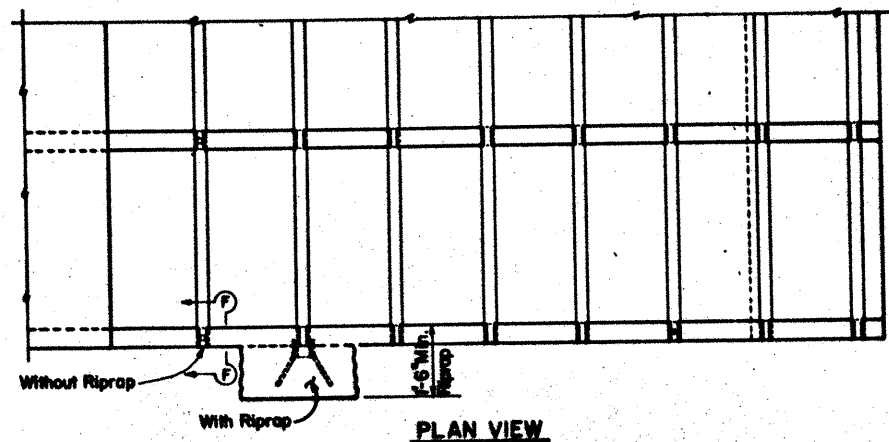

REQUIRED PIPE SIZES FOR GIVEN PIPE YIELD										
Culvert Size	Pipe Runner Length	35 ksi: ASTM A53, Ty. E & S Gr. B			42 ksi: ASTM A500, Gr. B			52 ksi: API 5LX52		
		Nom.	OD	ID	Nom.	OD	ID	Nom.	OD	ID
30"	42"	3"XS	3.500	2.900	2 1/2"XS	2.875	1.771	2 1/2"XS	2.875	1.771
		3 1/2"STD	4.000	3.548	3"STD	3.500	3.068	3"STD	3.500	3.068
36"	48"	3"XS	3.500	2.300	3"XS	3.500	2.900	3"Std	3.500	3.068
		3 1/2"XS	4.000	3.364	3 1/2"Std	4.000	3.548			
42"	54"	3"XS	3.500	2.300	3"XS	3.500	2.300	3"XS	3.500	2.900
		3 1/2"XS	4.000	3.364	3 1/2"XS	4.000	3.364	3 1/2"Std	4.000	3.548
48"	60"	3"XS	3.500	2.300	3"XS	3.500	2.300	3"XS	3.500	2.900
		4"XS	4.500	3.826	3 1/2"XS	4.000	3.364	3 1/2"Std	4.000	3.548
54"	66"	4"XS	4.500	3.826	3"XS	3.500	2.300	3"XS	3.500	2.300
		5"Std	5.563	5.047	4"Std	4.500	4.026	3 1/2"XS	4.000	3.364
60"	72"	4"XS	4.500	3.826	4"XS	4.500	3.826	3"XS	3.500	2.300
		5"Std	5.563	5.047	5"Std	5.563	5.047	3 1/2"XS	4.000	3.364

**GENERAL NOTES:**  
 These details are to be used as a guide for installation of safety pipe runners for parallel-drainage structures where out of control vehicles may impact the openings approximately perpendicular to the safety pipe runners. Some installations may require the preparation of special details. In general, safety pipe runners are installed on parallel-drainage structures at maximum spacings of approximately 24 inches.  
 Installation of safety pipe runners for single or multiple culverts will be in accordance with the details shown if the use of safety pipe runners are specified elsewhere in the plans.

Payment for riprap (if required) toe wall footing is included in the price bid for each Safety Pipe End Treatment.  
 Design: Safety Pipe Runners are designed for a traversing load of 10,000 pounds at yield as recommended by Research Report 280-2F, Safety Treatment of Roadside Parallel Drainage Structures, Texas Transportation Institute, June 1981.

STATE DEPARTMENT OF HIGHWAYS  
AND PUBLIC TRANSPORTATION

## PARALLEL DRAINAGE SAFETY PIPE RUNNERS

PD-SPR

ORIGINAL DRAWING DATE: JUNE 1985	STATE PROJECT: 15	FEDERAL PROJECT: 6	FEDERAL AID PROJECT: 18	SHEET: 18
REVISED: JUNE 1985	REVISED: JUNE 1985	REVISED: JUNE 1985	REVISED: JUNE 1985	REVISED: JUNE 1985
BY: JJP	BY: JJP	BY: JJP	BY: JJP	BY: JJP
CHK: JJP	CHK: JJP	CHK: JJP	CHK: JJP	CHK: JJP
APP: JJP	APP: JJP	APP: JJP	APP: JJP	APP: JJP
DES: JJP	DES: JJP	DES: JJP	DES: JJP	DES: JJP
CHK: JJP	CHK: JJP	CHK: JJP	CHK: JJP	CHK: JJP

