


Gas, Water and Sewer Lines on approximate locations  
Storm Sewer alignment may be changed as conditions  
on the ground warrant. No borings made.

Scale of Plan 1"=20'

Vert. Scale 1" = 6'

Hor. Scale 1"=20'

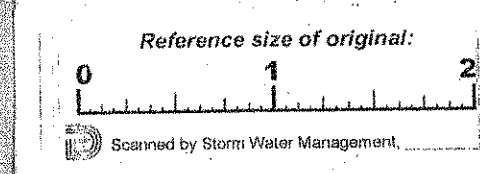

STORM SEWER					
CEDAR CREEK DIST NO. 21-D					
THIRTIETH & LANCASTER					
CITY ENGINEERS OFFICE					
DALLAS, TEXAS,					
Drawn	Traced	Capt.	Checked	INB	No.
Boer	Boer	1030	Noted	9-74	427Q