


MATCH SHEET 633

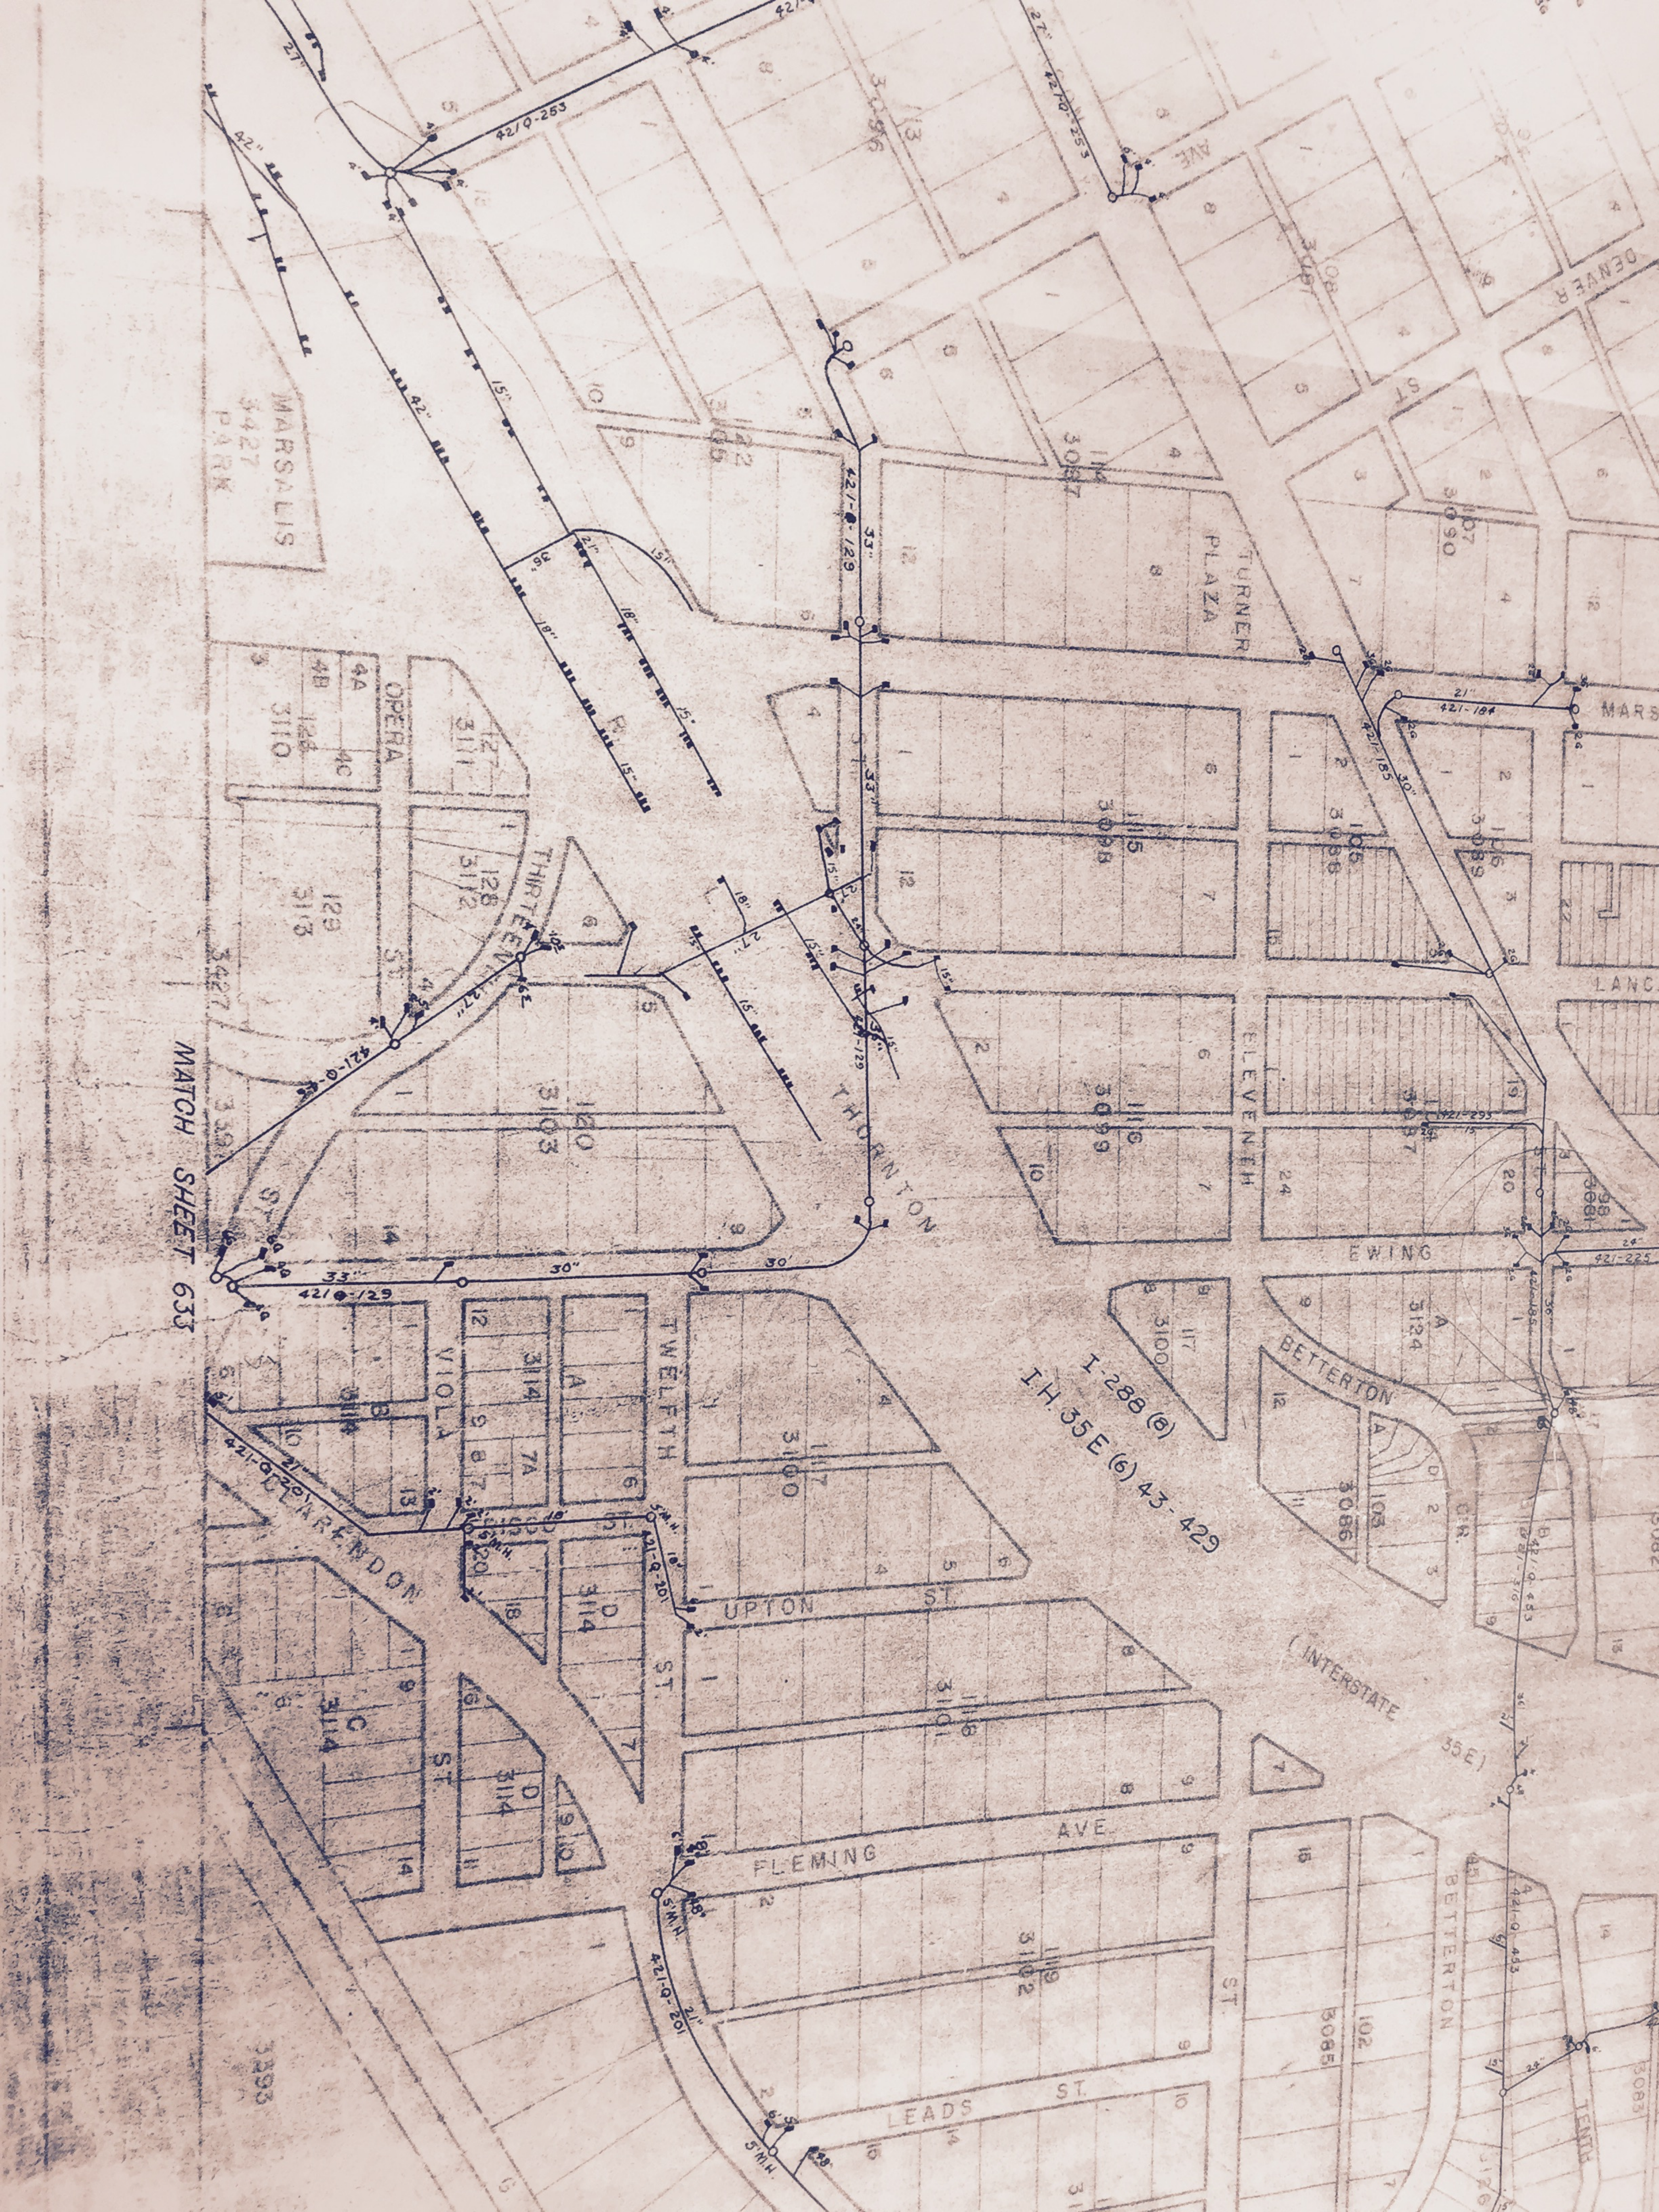





MATCH SHEET 610

